


GROUND FLOOR PLAN
ΚΑΤΟΨΗ ΙΣΟΓΕΙΟΥ

ΥΠΟΜΝΗΜΑ
LEGEND

	DATA CABLE SHIELDED 2x1.5mm ² (FIRE RESISTANT TYPE)
	POWER CABLE 2x2.5mm ² 24V D.C. (FIRE RESISTANT TYPE)
	POWER CABLE 2x1.5mm ² 24V D.C. (FIRE RESISTANT TYPE)
	CONTROL MODULE
	MONITOR MODULE
	ADDRESSABLE FIRE ALARM CALL POINT (BREAK GLASS PUSHBUTTON)
	FIRE ALARM CHIME
	FIXED RATE OF RISE HEAT ADDRESSABLE TYPE DETECTOR WITH ALARM INDICATING LED
	SMOKE PHOTOELECTRONIC ADDRESSABLE TYPE DETECTOR WITH ALARM INDICATING LED
	SMOKE IONIZATION ADDRESSABLE TYPE DETECTOR WITH ALARM INDICATING LED
	FIXED RATE OF RISE HEAT SMOKE PHOTOELECTRONIC AND IONIZATION ADDRESSABLE TYPE DETECTORS WITH ALARM INDICATING LED
	FIXED TYPE LINEAR HEAT ADDRESSABLE TYPE DETECTOR
	FIXED RATE OF RISE HEAT AND SMOKE PHOTOELECTRONIC ADDRESSABLE TYPE DETECTORS WITH ALARM INDICATING LED
	FIXED RATE OF RISE HEAT AND SMOKE IONIZATION ADDRESSABLE TYPE DETECTORS WITH ALARM INDICATING LED
	SPARK ADDRESSABLE TYPE DETECTOR
	AUDIO VISUAL PREWARNING DEVICE WITH INTERNAL SOUNDER AND FLUORESCENT LIGHT 3W/24V DC

ΠΑΡΑΤΗΡΗΣΕΙΣ
NOTES


- ΟΙ ΣΙΔΗΡΕΣ ΕΓΓΡΑΦΜΟΙ ΤΟΠΟΘΕΤΟΥΝΤΑΙ ΣΕ ΎΨΟΣ 3m ΑΠΟ Τ.Α.
FIRE ALARM CHIMES ARE INSTALLED AT 3m ABOVE FFL
- ΤΑ ΚΟΜΒΙΑ ΕΓΓΡΑΦΜΟΙ ΤΟΠΟΘΕΤΟΥΝΤΑΙ ΣΕ ΎΨΟΣ 1.30m - 1.50m ΑΠΟ Τ.Α.
FIRE ALARM CALL POINTS ARE INSTALLED AT 1.30m - 1.50m ABOVE FFL
- ΤΑ ΚΑΒΛΙΑ ΘΑ ΤΟΠΟΘΕΤΟΥΝΤΑΙ ΣΕ ΕΣΧΑΡΕΣ ΚΑΝΟΝΩΝ Ή ΣΕ ΒΡΑΝΙΚΑΤΣΕΤΣ ΕΣΩΓΗΝΕΣ ΑΠΟ ΕΚΧΗΡΟ PVC
THE CABLES SHALL BE INSTALLED ON TRAYS OR IN FLAME RETARDANT RIGID PVC CONDUITS

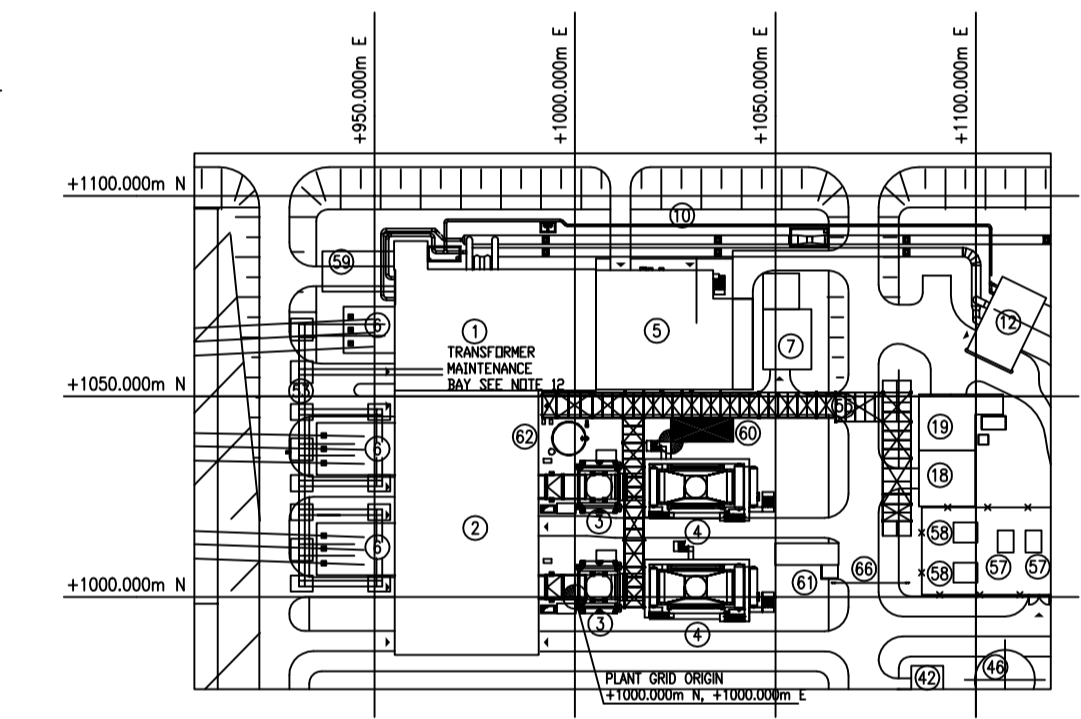

REV	DATE	DRAWN	CHECKED	FOR AECEK	NOTES	STATUS
1	21-03-02	S.MOSCHOVAKI	M.PETSIOS	E.SPANOS	AS BUILT ISSUE	0
0	02-04-01	S.TSIAMADAS	M.PETSIOS	E.SPANOS	FIRST ISSUE	0



IN CONSORTIUM FOR :

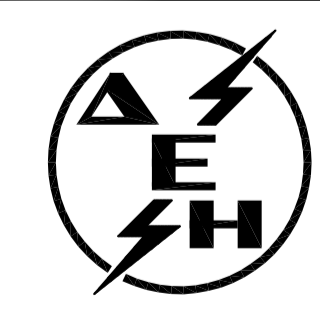

PUBLIC POWER CORPORATION (PPC)
ATHENS - GREECE
KOMOTINI COMBINED CYCLE POWER PLANT
476,3 MW
CONTRACT No. DMKT - 165/99141

ISSUED/RELEASED BY :



PROJECT DRWG No. **E 9 CYE U 060**
TITLE
**DOSING LAB -60-
FIRE DETECTION SYSTEM**

NAME	DATE	DOC. TYPE	SUPPLIER	SIZE	SCALE	SHEET
DRAWN S.MOSCHOVAKI	03-02			A1	1:50	1 of 1
CHECKED M.PETSIOS	03-02					
FOR AECEK E.SPANOS	03-02					