


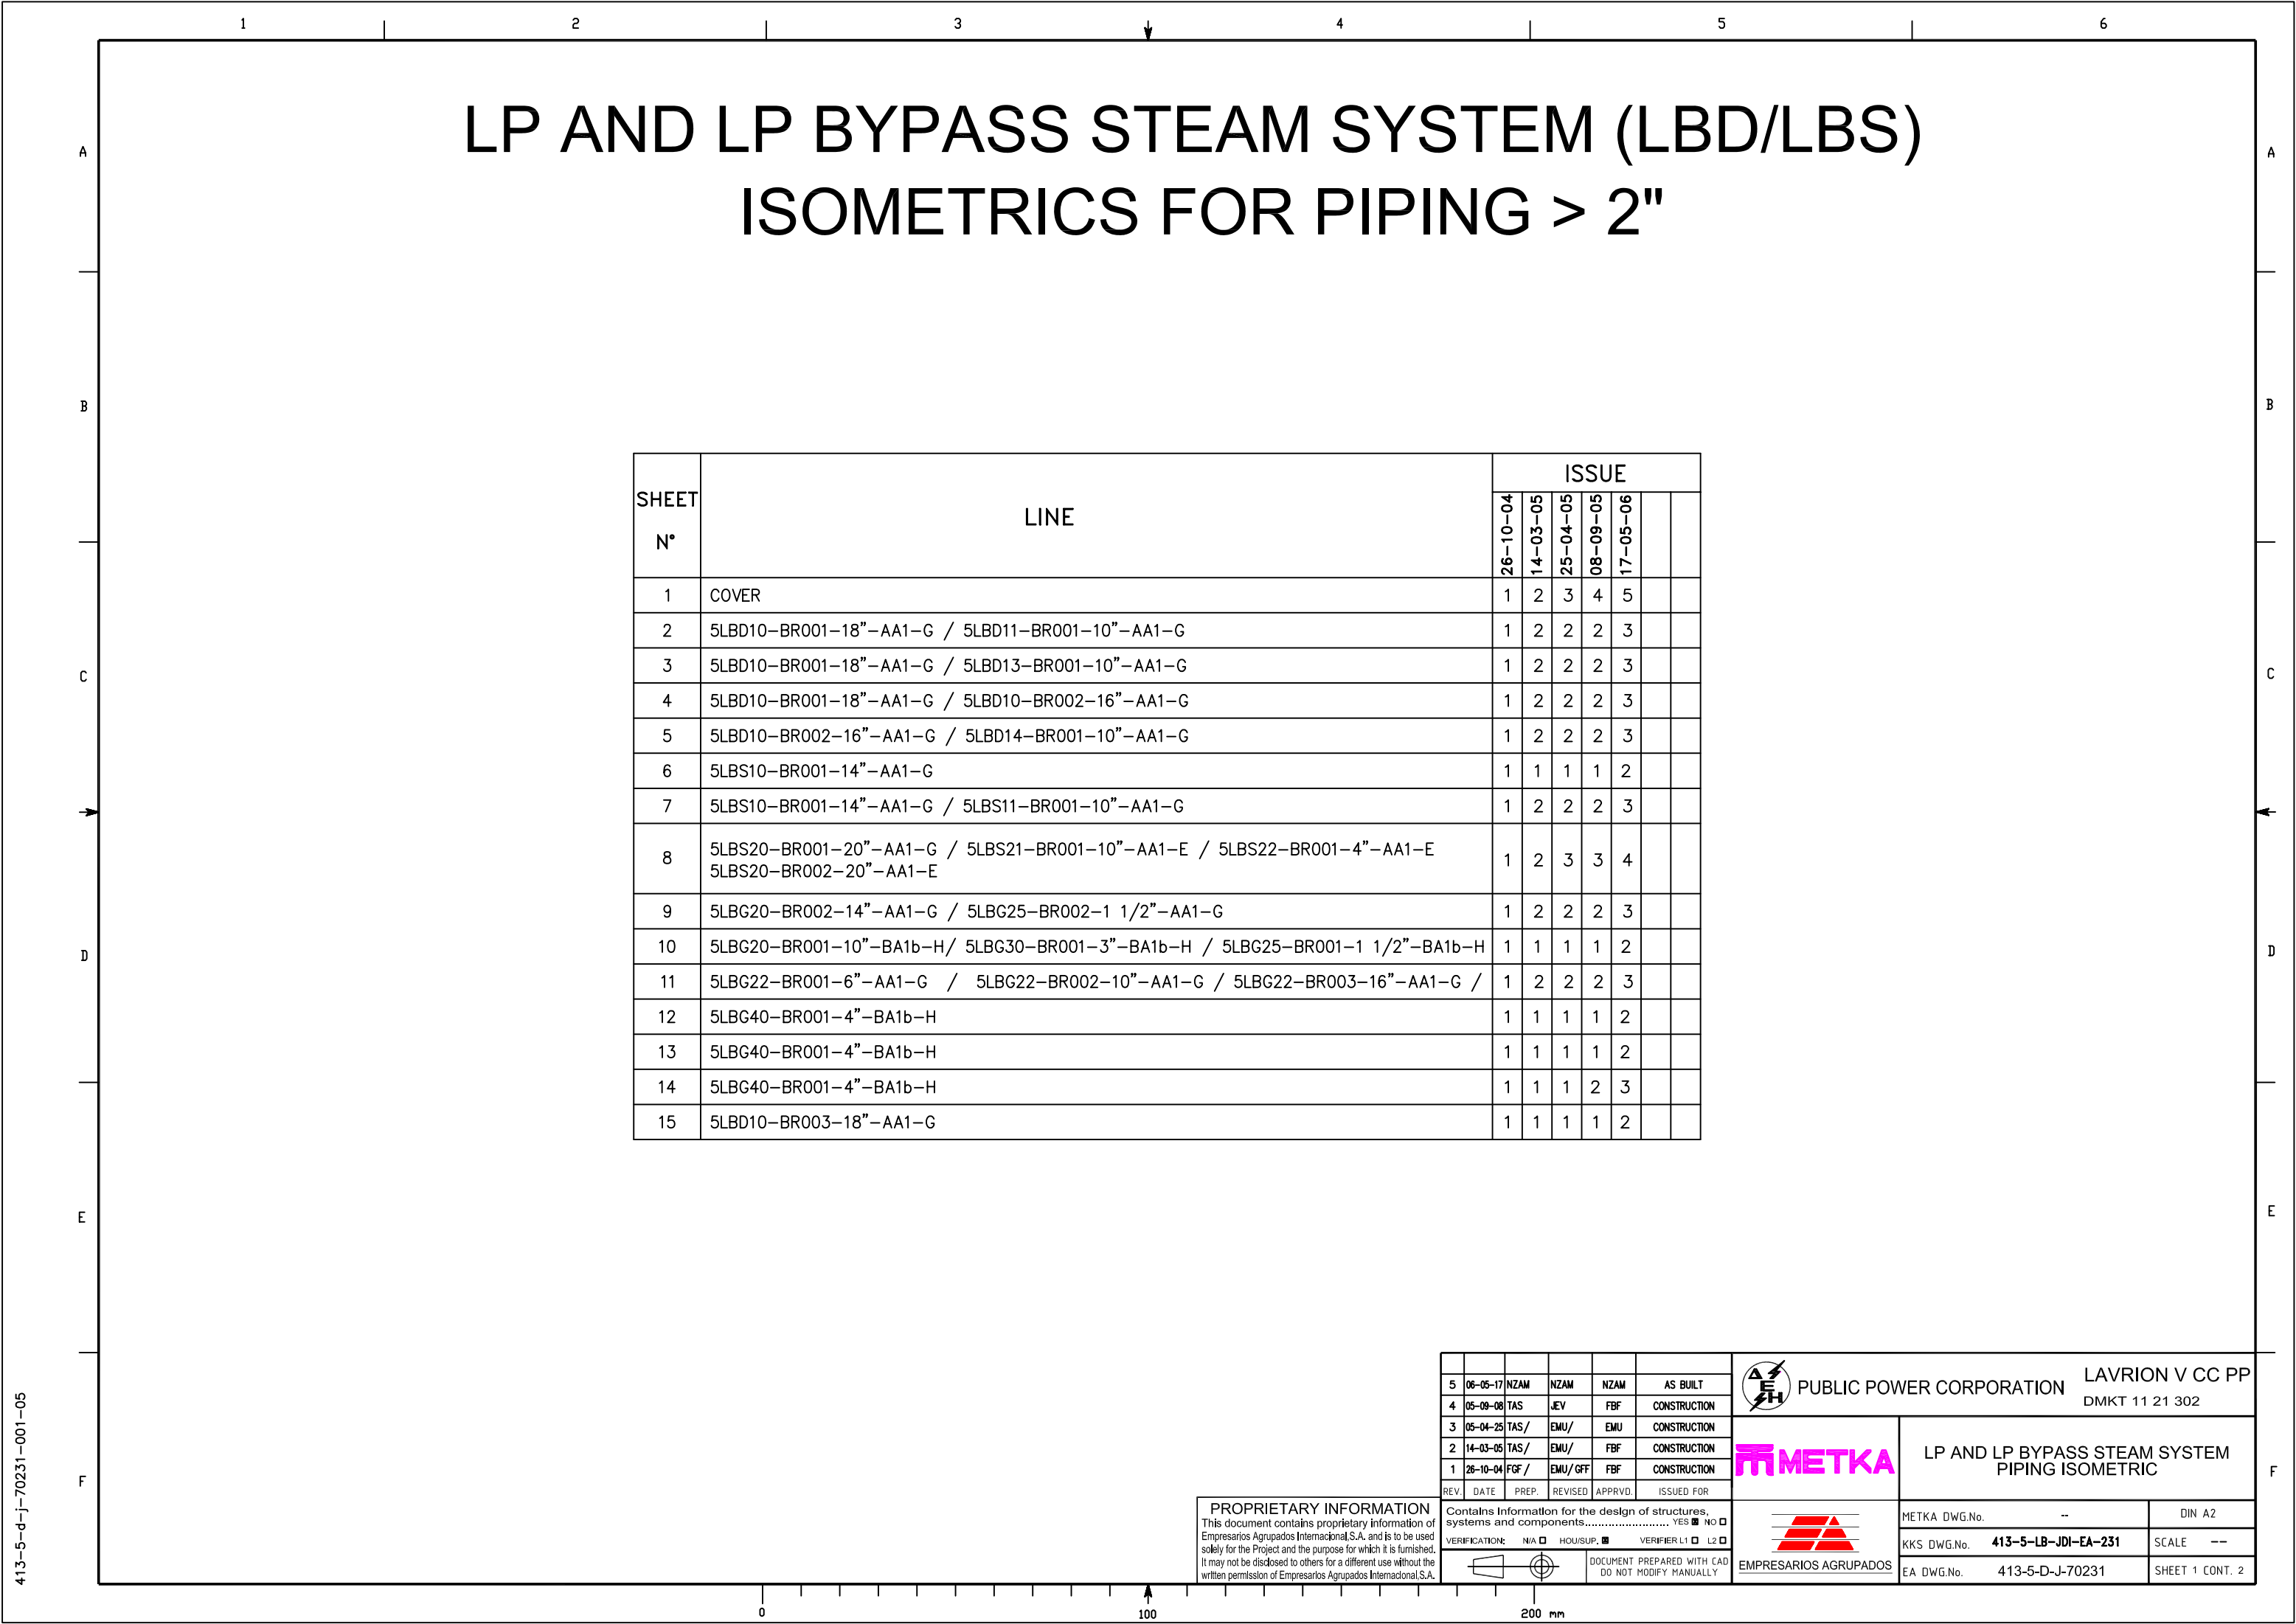

# LP AND LP BYPASS STEAM SYSTEM (LBD/LBS) ISOMETRICS FOR PIPING > 2"

| SHEET<br>N° | LINE                                                                                              | ISSUE    |          |          |          |          |  |
|-------------|---------------------------------------------------------------------------------------------------|----------|----------|----------|----------|----------|--|
|             |                                                                                                   | 26-10-04 | 14-03-05 | 25-04-05 | 08-09-05 | 17-05-06 |  |
| 1           | COVER                                                                                             | 1        | 2        | 3        | 4        | 5        |  |
| 2           | 5LBD10-BR001-18"-AA1-G / 5LBD11-BR001-10"-AA1-G                                                   | 1        | 2        | 2        | 2        | 3        |  |
| 3           | 5LBD10-BR001-18"-AA1-G / 5LBD13-BR001-10"-AA1-G                                                   | 1        | 2        | 2        | 2        | 3        |  |
| 4           | 5LBD10-BR001-18"-AA1-G / 5LBD10-BR002-16"-AA1-G                                                   | 1        | 2        | 2        | 2        | 3        |  |
| 5           | 5LBD10-BR002-16"-AA1-G / 5LBD14-BR001-10"-AA1-G                                                   | 1        | 2        | 2        | 2        | 3        |  |
| 6           | 5LBS10-BR001-14"-AA1-G                                                                            | 1        | 1        | 1        | 1        | 2        |  |
| 7           | 5LBS10-BR001-14"-AA1-G / 5LBS11-BR001-10"-AA1-G                                                   | 1        | 2        | 2        | 2        | 3        |  |
| 8           | 5LBS20-BR001-20"-AA1-G / 5LBS21-BR001-10"-AA1-E / 5LBS22-BR001-4"-AA1-E<br>5LBS20-BR002-20"-AA1-E | 1        | 2        | 3        | 3        | 4        |  |
| 9           | 5LBG20-BR002-14"-AA1-G / 5LBG25-BR002-1 1/2"-AA1-G                                                | 1        | 2        | 2        | 2        | 3        |  |
| 10          | 5LBG20-BR001-10"-BA1b-H / 5LBG30-BR001-3"-BA1b-H / 5LBG25-BR001-1 1/2"-BA1b-H                     | 1        | 1        | 1        | 1        | 2        |  |
| 11          | 5LBG22-BR001-6"-AA1-G / 5LBG22-BR002-10"-AA1-G / 5LBG22-BR003-16"-AA1-G /                         | 1        | 2        | 2        | 2        | 3        |  |
| 12          | 5LBG40-BR001-4"-BA1b-H                                                                            | 1        | 1        | 1        | 1        | 2        |  |
| 13          | 5LBG40-BR001-4"-BA1b-H                                                                            | 1        | 1        | 1        | 1        | 2        |  |
| 14          | 5LBG40-BR001-4"-BA1b-H                                                                            | 1        | 1        | 1        | 2        | 3        |  |
| 15          | 5LBD10-BR003-18"-AA1-G                                                                            | 1        | 1        | 1        | 1        | 2        |  |

413-5-d-j-70231-001-05

**PROPRIETARY INFORMATION**  
This document contains proprietary information of  
Empresarios Agrupados Internacional S.A. and is to be used  
solely for the Project and the purpose for which it is furnished.  
It may not be disclosed to others for a different use without the  
written permission of Empresarios Agrupados Internacional S.A.

|      |          |       |         |         |              |
|------|----------|-------|---------|---------|--------------|
| 5    | 06-05-17 | NZAM  | NZAM    | NZAM    | AS BUILT     |
| 4    | 05-09-08 | TAS   | JEV     | FBF     | CONSTRUCTION |
| 3    | 05-04-25 | TAS/  | EMU/    | EMU     | CONSTRUCTION |
| 2    | 14-03-05 | TAS/  | EMU/    | FBF     | CONSTRUCTION |
| 1    | 26-10-04 | FCF/  | EMU/GFF | FBF     | CONSTRUCTION |
| REV. | DATE     | PREP. | REVISED | APPRVD. | ISSUED FOR   |

|                                                      |                              |                                  |                                                                  |
|------------------------------------------------------|------------------------------|----------------------------------|------------------------------------------------------------------|
| VERIFICATION:                                        | N/A <input type="checkbox"/> | HOUSUP. <input type="checkbox"/> | VERIFIER L1 <input type="checkbox"/> L2 <input type="checkbox"/> |
| DOCUMENT PREPARED WITH CAD<br>DO NOT MODIFY MANUALLY |                              |                                  |                                                                  |



PUBLIC POWER CORPORATION LAVRION V CC PP  
DMKT 11 21 302




LP AND LP BYPASS STEAM SYSTEM  
PIPING ISOMETRIC



|               |                     |                 |
|---------------|---------------------|-----------------|
| METKA DWG.No. | --                  | DIN A2          |
| KKS DWG.No.   | 413-5-LB-JDI-EA-231 | SCALE --        |
| EA DWG.No.    | 413-5-D-J-70231     | SHEET 1 CONT. 2 |



**PROPRIETARY INFORMATION**  
This document contains proprietary information of  
Empresarios Agrupados Internacional, S.A. and is to be used  
solely for the Project and the purpose for which it is furnished.  
It may not be disclosed to others for a different use without the  
written permission of Empresarios Agrupados Internacional, S.A.

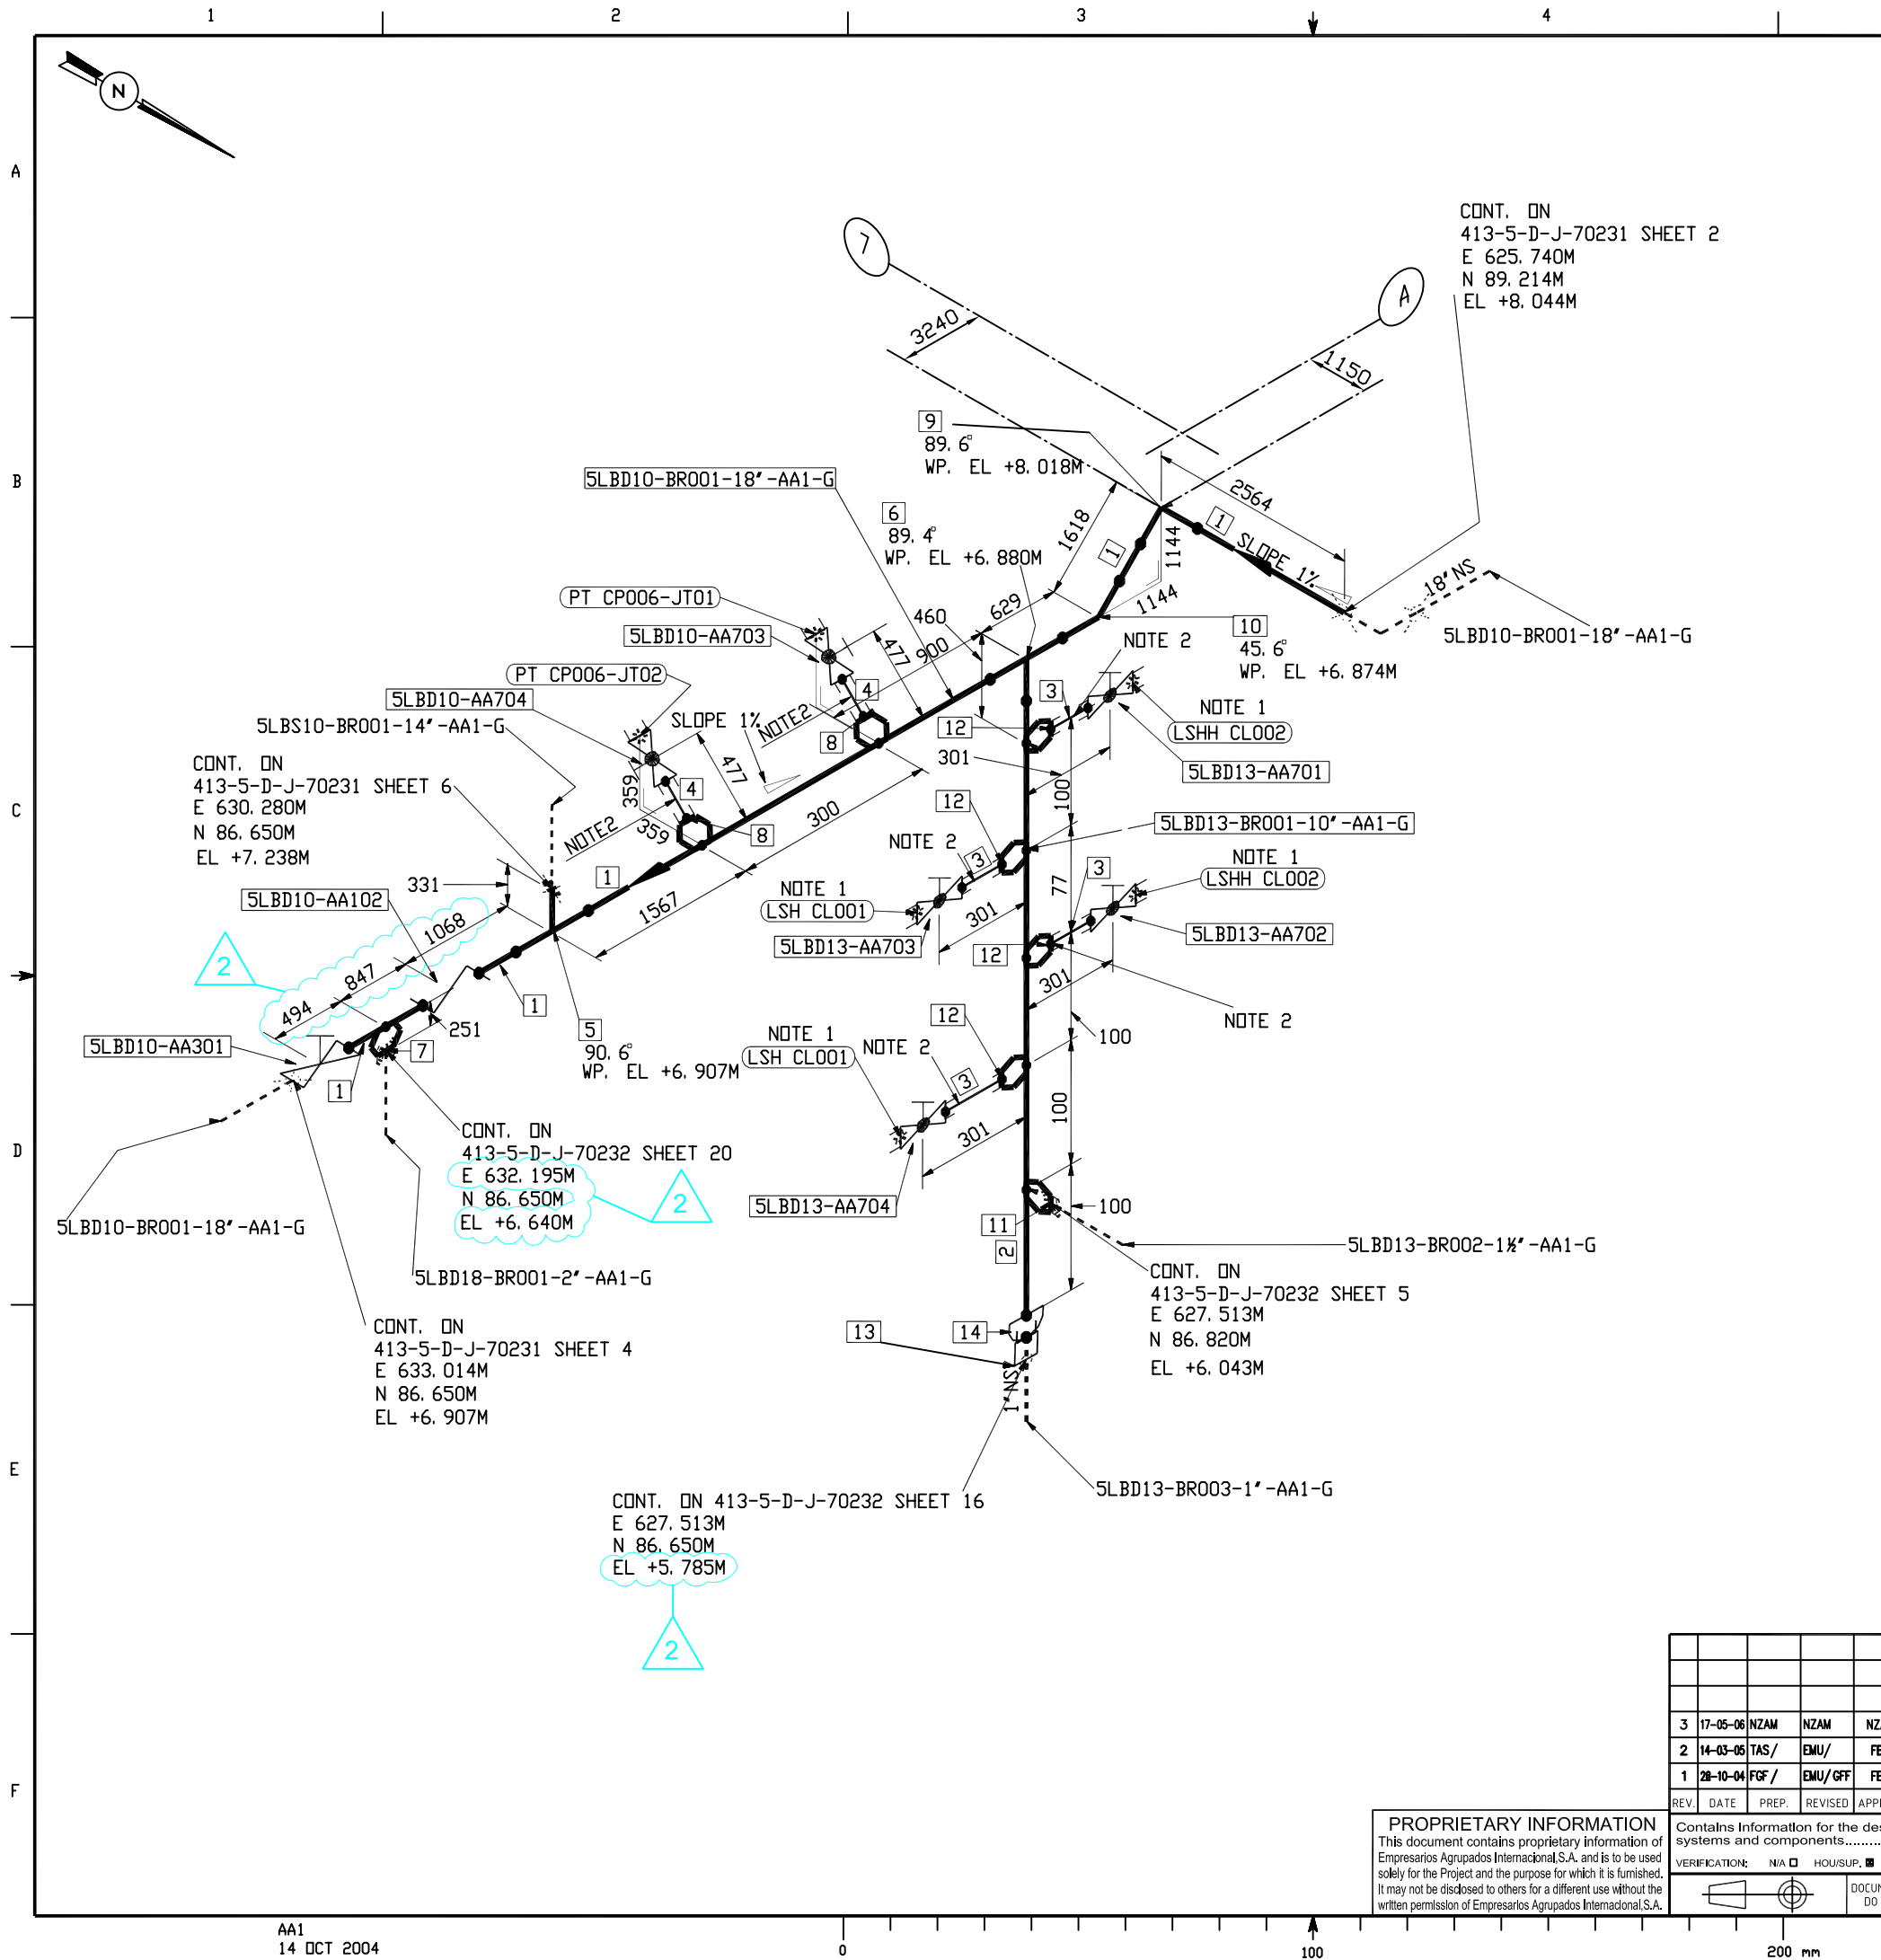

| MATERIAL LIST |          |                                                   |       |
|---------------|----------|---------------------------------------------------|-------|
| Nº            | (Inch.)  | DESCRIPTION / MATERIAL                            | QTY.  |
| 1             | 18       | PIPE, S-STD, BE,.....ASTM-A106-GrB                | 5.5 M |
| 2             | 10       | PIPE, S- 40, BE,.....ASTM-A106-GrB                | 0.7 M |
| 3             | 1        | PIPE, S-80 , PE,.....ASTM-A106-GrB                | 0.4 M |
| 4             | 3/4      | PIPE, S-80 , PE,.....ASTM-A106-GrB                | 0.5 M |
| 5             | 18X14    | REDUCER TEE, S-STD x S-STD, BE,.....ASTM-A234-WPB | 1     |
| 6             | 18X10    | REDUCER TEE, S-STD x S-40, BE,.....ASTM-A234-WPB  | 1     |
| 7             | 18X2     | SOCKOLET, CL3000, BE/SWE,.....ASTM-A105           | 1     |
| 8             | 18X3/4   | SOCKOLET, CL3000, BE/SWE,.....ASTM-A105           | 2     |
| 9             | 18       | LR 90 GR ELBOW, S-STD, BE,.....ASTM-A234-WPB      | 1     |
| 10            | 18       | LR 45 GR ELBOW, S-STD, BE,.....ASTM-A234-WPB      | 1     |
| 11            | 10X1.1/2 | SOCKOLET, CL3000, BE/SWE,.....ASTM-A105           | 1     |
| 12            | 10X1     | SOCKOLET, CL3000, BE/SWE,.....ASTM-A105           | 4     |
| 13            | 10X1     | HALF COUPLING, CL3000, SWE,.....ASTM-A105         | 1     |
| 14            | 10       | CAP, S-40, BE,.....ASTM-A234-WPB                  | 1     |

| REFERENCE DRAWINGS  |                      |
|---------------------|----------------------|
| Piping Composite    | P&ID Nº.             |
| 413-5-D-M-60151 SH2 | 413-5-DT-M-10200 SH2 |
|                     |                      |
|                     |                      |
|                     |                      |

NOTES:

- 1.- LSH & LSHH PIPES MUST BE INSTALLED COMPLETELY HORIZONTAL
- 2.- 3" LONG PIECE OF PIPE PLUS THE LENGTH CORRESPONDING TO THE INSULATION THICKNESS
- 3.- THE LENGTHS OF THE STRAIGHT PIPE SECTIONS HAVE BEEN OBTAINED TAKING INTO ACCOUNT THE DISTANCE BETWEEN VALVE FACES ACCORDING TO STANDARD ANSI B16.10 FINAL DIMENSION SHALL BE DEFINED BY THE FABRICATOR BASED ON VALVE SUPPLIER DRAWINGS.

LINES No. = 5LBD10-BR001-18'-AA1-G  
5LBD13-BR001-10'-AA1-G

 PUBLIC POWER CORPORATION LAVRION V CC PP  
DMKT 11 21 302

 LP AND LP BYPASS STEAM SYSTEM  
PIPING ISOMETRIC

|               |                     |                 |
|---------------|---------------------|-----------------|
| METKA DWG.No. | --                  | DIN A2          |
| KKS DWG.No.   | 413-5-LB-JDI-EA-231 | SCALE --        |
| EA DWG.No.    | 413-5-D-J-70231     | SHEET 3 CONT. 4 |

| REV. | DATE     | PREP. | REVISED | APPRVD. | ISSUED FOR   |
|------|----------|-------|---------|---------|--------------|
| 3    | 17-05-06 | NZAM  | NZAM    | NZAM    | AS BUILT     |
| 2    | 14-03-05 | TAS/  | EMU/    | FBF     | CONSTRUCTION |
| 1    | 28-10-04 | FCF/  | EMU/GFF | FBF     | CONSTRUCTION |

 
PROPRIETARY INFORMATION  
This document contains proprietary information of Empresarios Agrupados Internacional,S.A. and is to be used solely for the Project and the purpose for which it is furnished. It may not be disclosed to others for a different use without the written permission of Empresarios Agrupados Internacional,S.A.

Contains Information for the design of structures, systems and components..... YES ☒ NO ☐

VERIFICATION: N/A ☐ HOUSE/UP. ☒ VERIFIER L1 ☐ L2 ☐


DOCUMENT PREPARED WITH CAD  
DO NOT MODIFY MANUALLY







413-5-d-j-70231-006-02

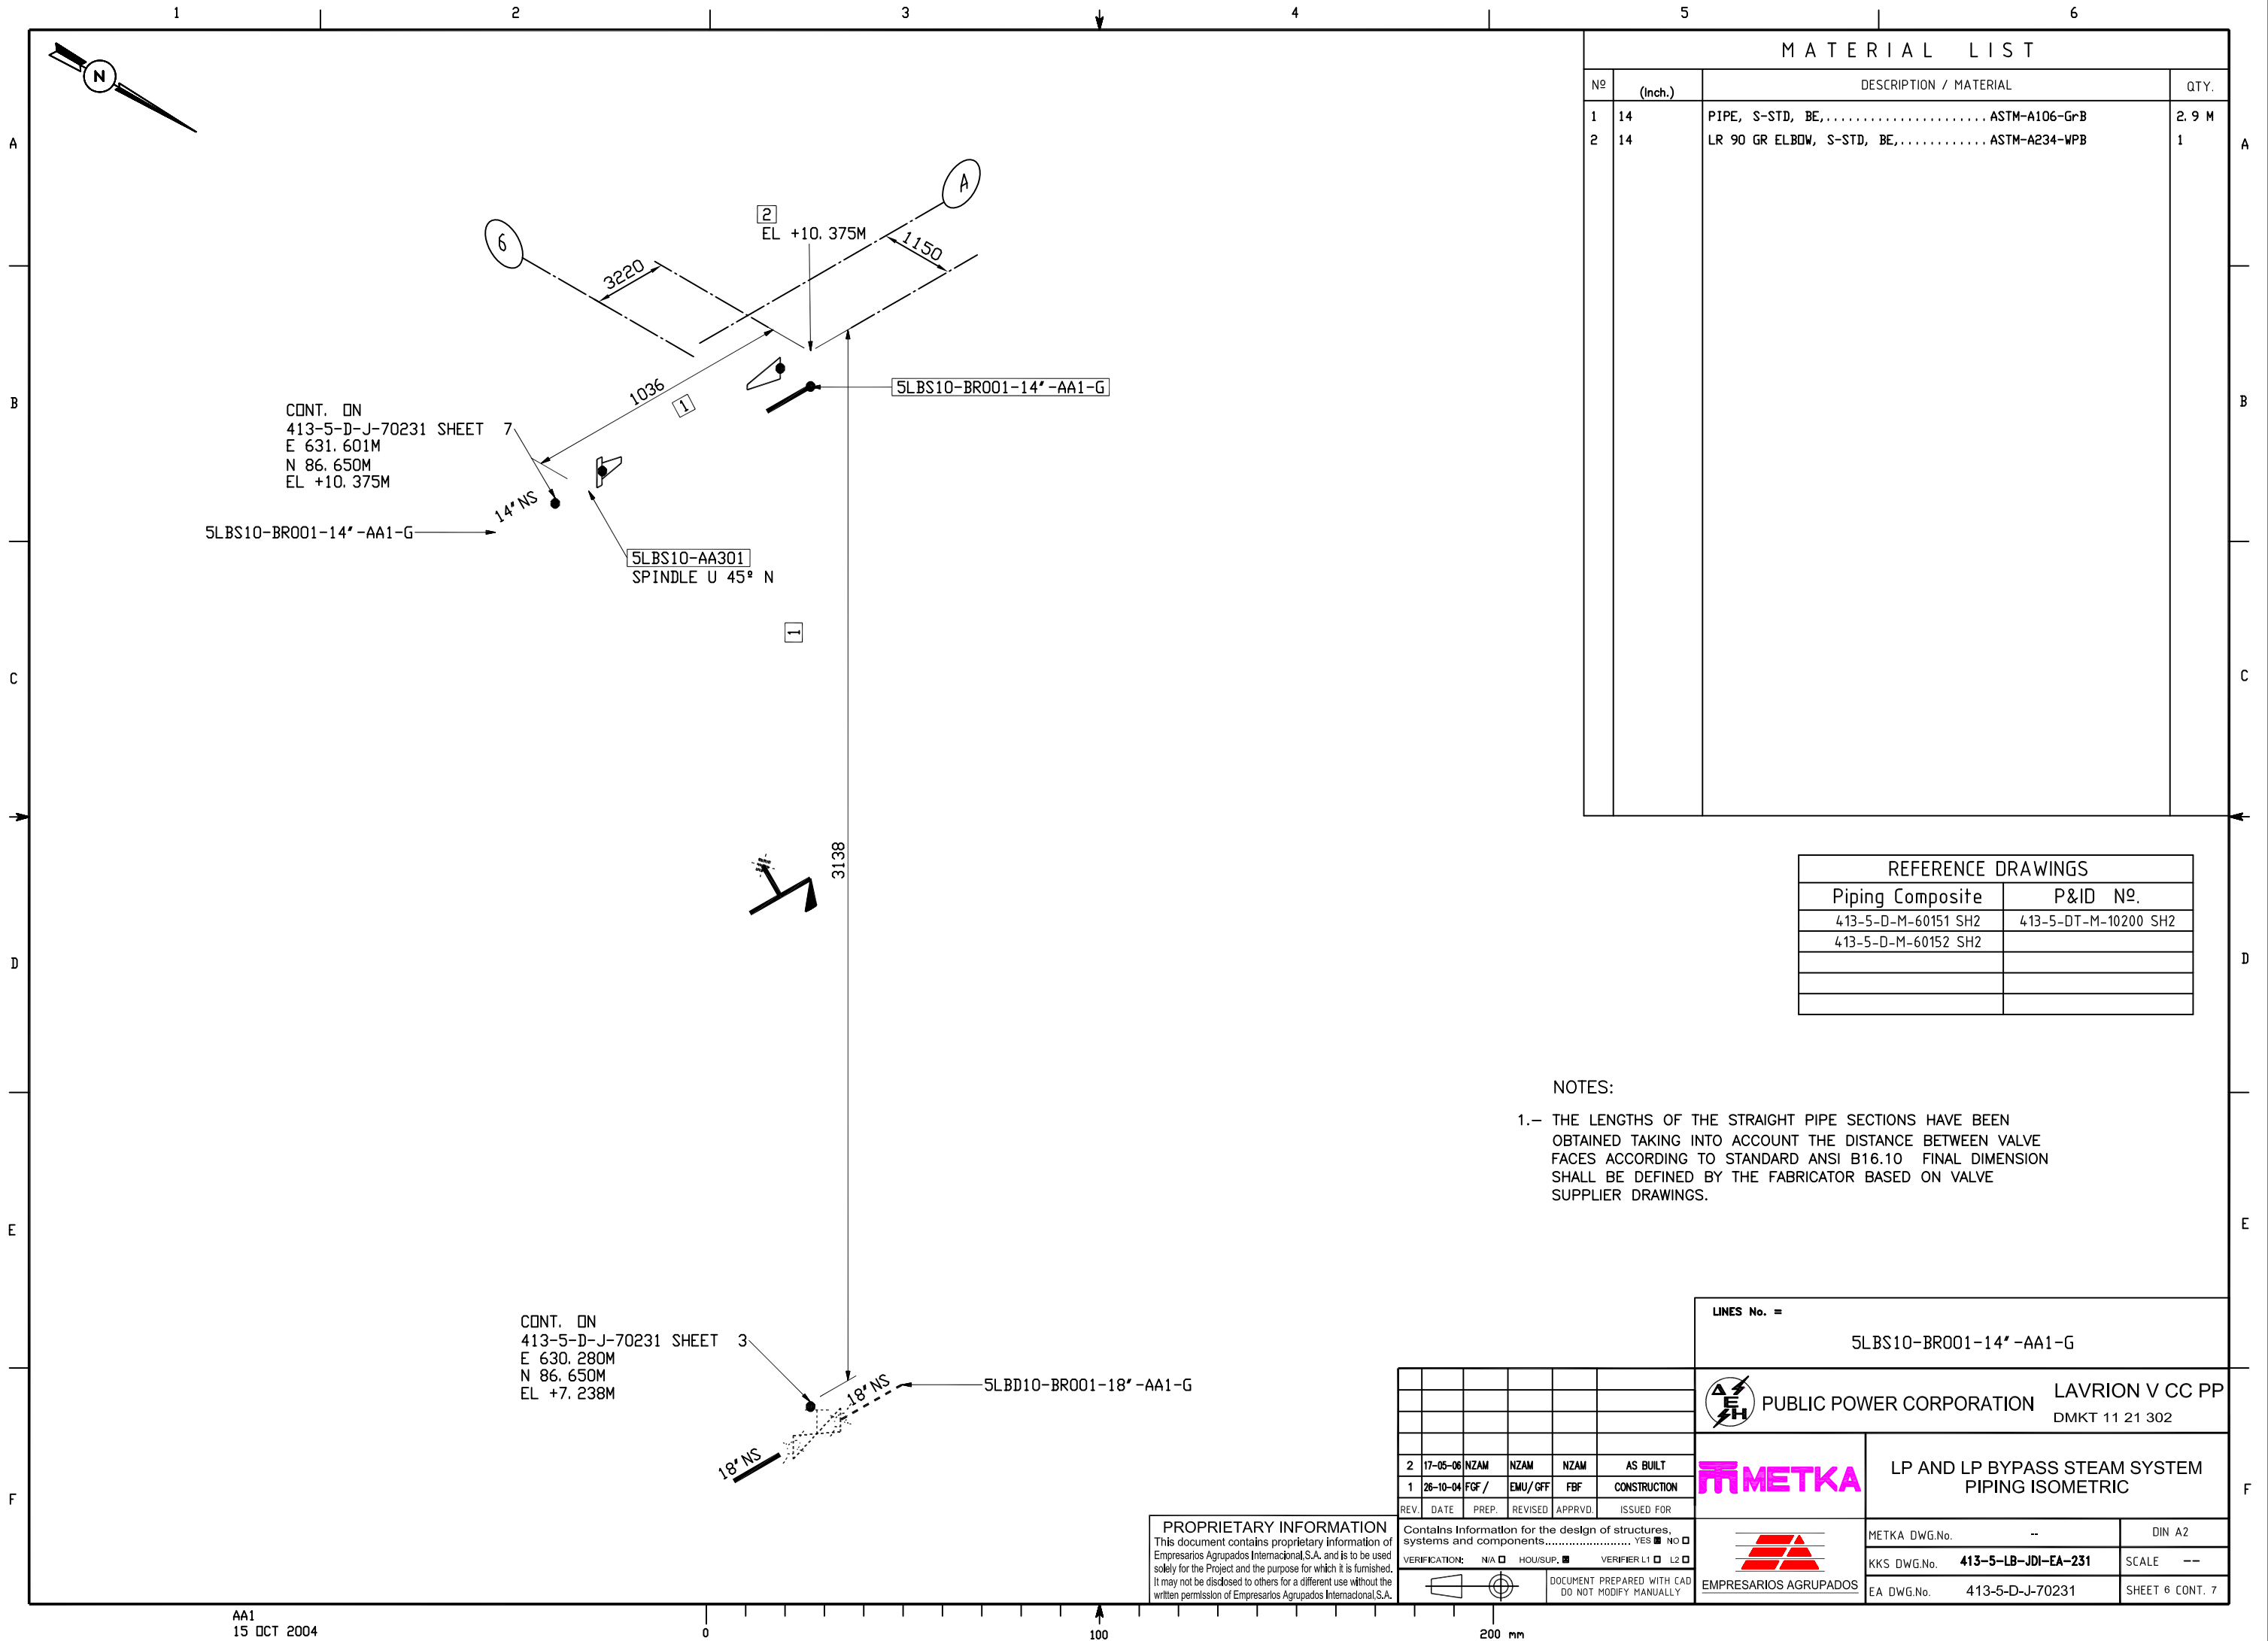

| MATERIAL LIST |         |                                               |       |
|---------------|---------|-----------------------------------------------|-------|
| Nº            | (Inch.) | DESCRIPTION / MATERIAL                        | QTY.  |
| 1             | 14      | PIPE, S-STD, BE,..... ASTM-A106-GrB           | 2.9 M |
| 2             | 14      | LR 90 GR ELBOW, S-STD, BE,..... ASTM-A234-WPB | 1     |

| REFERENCE DRAWINGS  |                      |
|---------------------|----------------------|
| Piping Composite    | P&ID Nº.             |
| 413-5-D-M-60151 SH2 | 413-5-DT-M-10200 SH2 |
| 413-5-D-M-60152 SH2 |                      |
|                     |                      |
|                     |                      |

NOTES:


- 1.- THE LENGTHS OF THE STRAIGHT PIPE SECTIONS HAVE BEEN OBTAINED TAKING INTO ACCOUNT THE DISTANCE BETWEEN VALVE FACES ACCORDING TO STANDARD ANSI B16.10 FINAL DIMENSION SHALL BE DEFINED BY THE FABRICATOR BASED ON VALVE SUPPLIER DRAWINGS.

|             |  |                                                   |                 |
|-------------|--|---------------------------------------------------|-----------------|
| LINES No. = |  | 5LBS10-BR001-14'-AA1-G                            |                 |
|             |  | LAVRION V CC PP<br>DMKT 11 21 302                 |                 |
|             |  | LP AND LP BYPASS STEAM SYSTEM<br>PIPING ISOMETRIC |                 |
|             |  | METKA DWG.No. --                                  | DIN A2          |
|             |  | KKS DWG.No. 413-5-LB-JDI-EA-231                   | SCALE --        |
|             |  | EA DWG.No. 413-5-D-J-70231                        | SHEET 6 CONT. 7 |

**PROPRIETARY INFORMATION**  
This document contains proprietary information of Empresarios Agrupados Internacional,S.A. and is to be used solely for the Project and the purpose for which it is furnished. It may not be disclosed to others for a different use without the written permission of Empresarios Agrupados Internacional,S.A.

|      |          |                                                                                                                                                           |         |                                                      |              |
|------|----------|-----------------------------------------------------------------------------------------------------------------------------------------------------------|---------|------------------------------------------------------|--------------|
| 2    | 17-05-06 | NZAM                                                                                                                                                      | NZAM    | NZAM                                                 | AS BUILT     |
| 1    | 26-10-04 | FCF /                                                                                                                                                     | EMU/GFF | FBF                                                  | CONSTRUCTION |
| REV. | DATE     | PREP.                                                                                                                                                     | REVISED | APPRVD.                                              | ISSUED FOR   |
|      |          | VERIFICATION: N/A <input type="checkbox"/> HOUSE/UP. <input checked="" type="checkbox"/> VERIFIER L1 <input type="checkbox"/> L2 <input type="checkbox"/> |         | DOCUMENT PREPARED WITH CAD<br>DO NOT MODIFY MANUALLY |              |



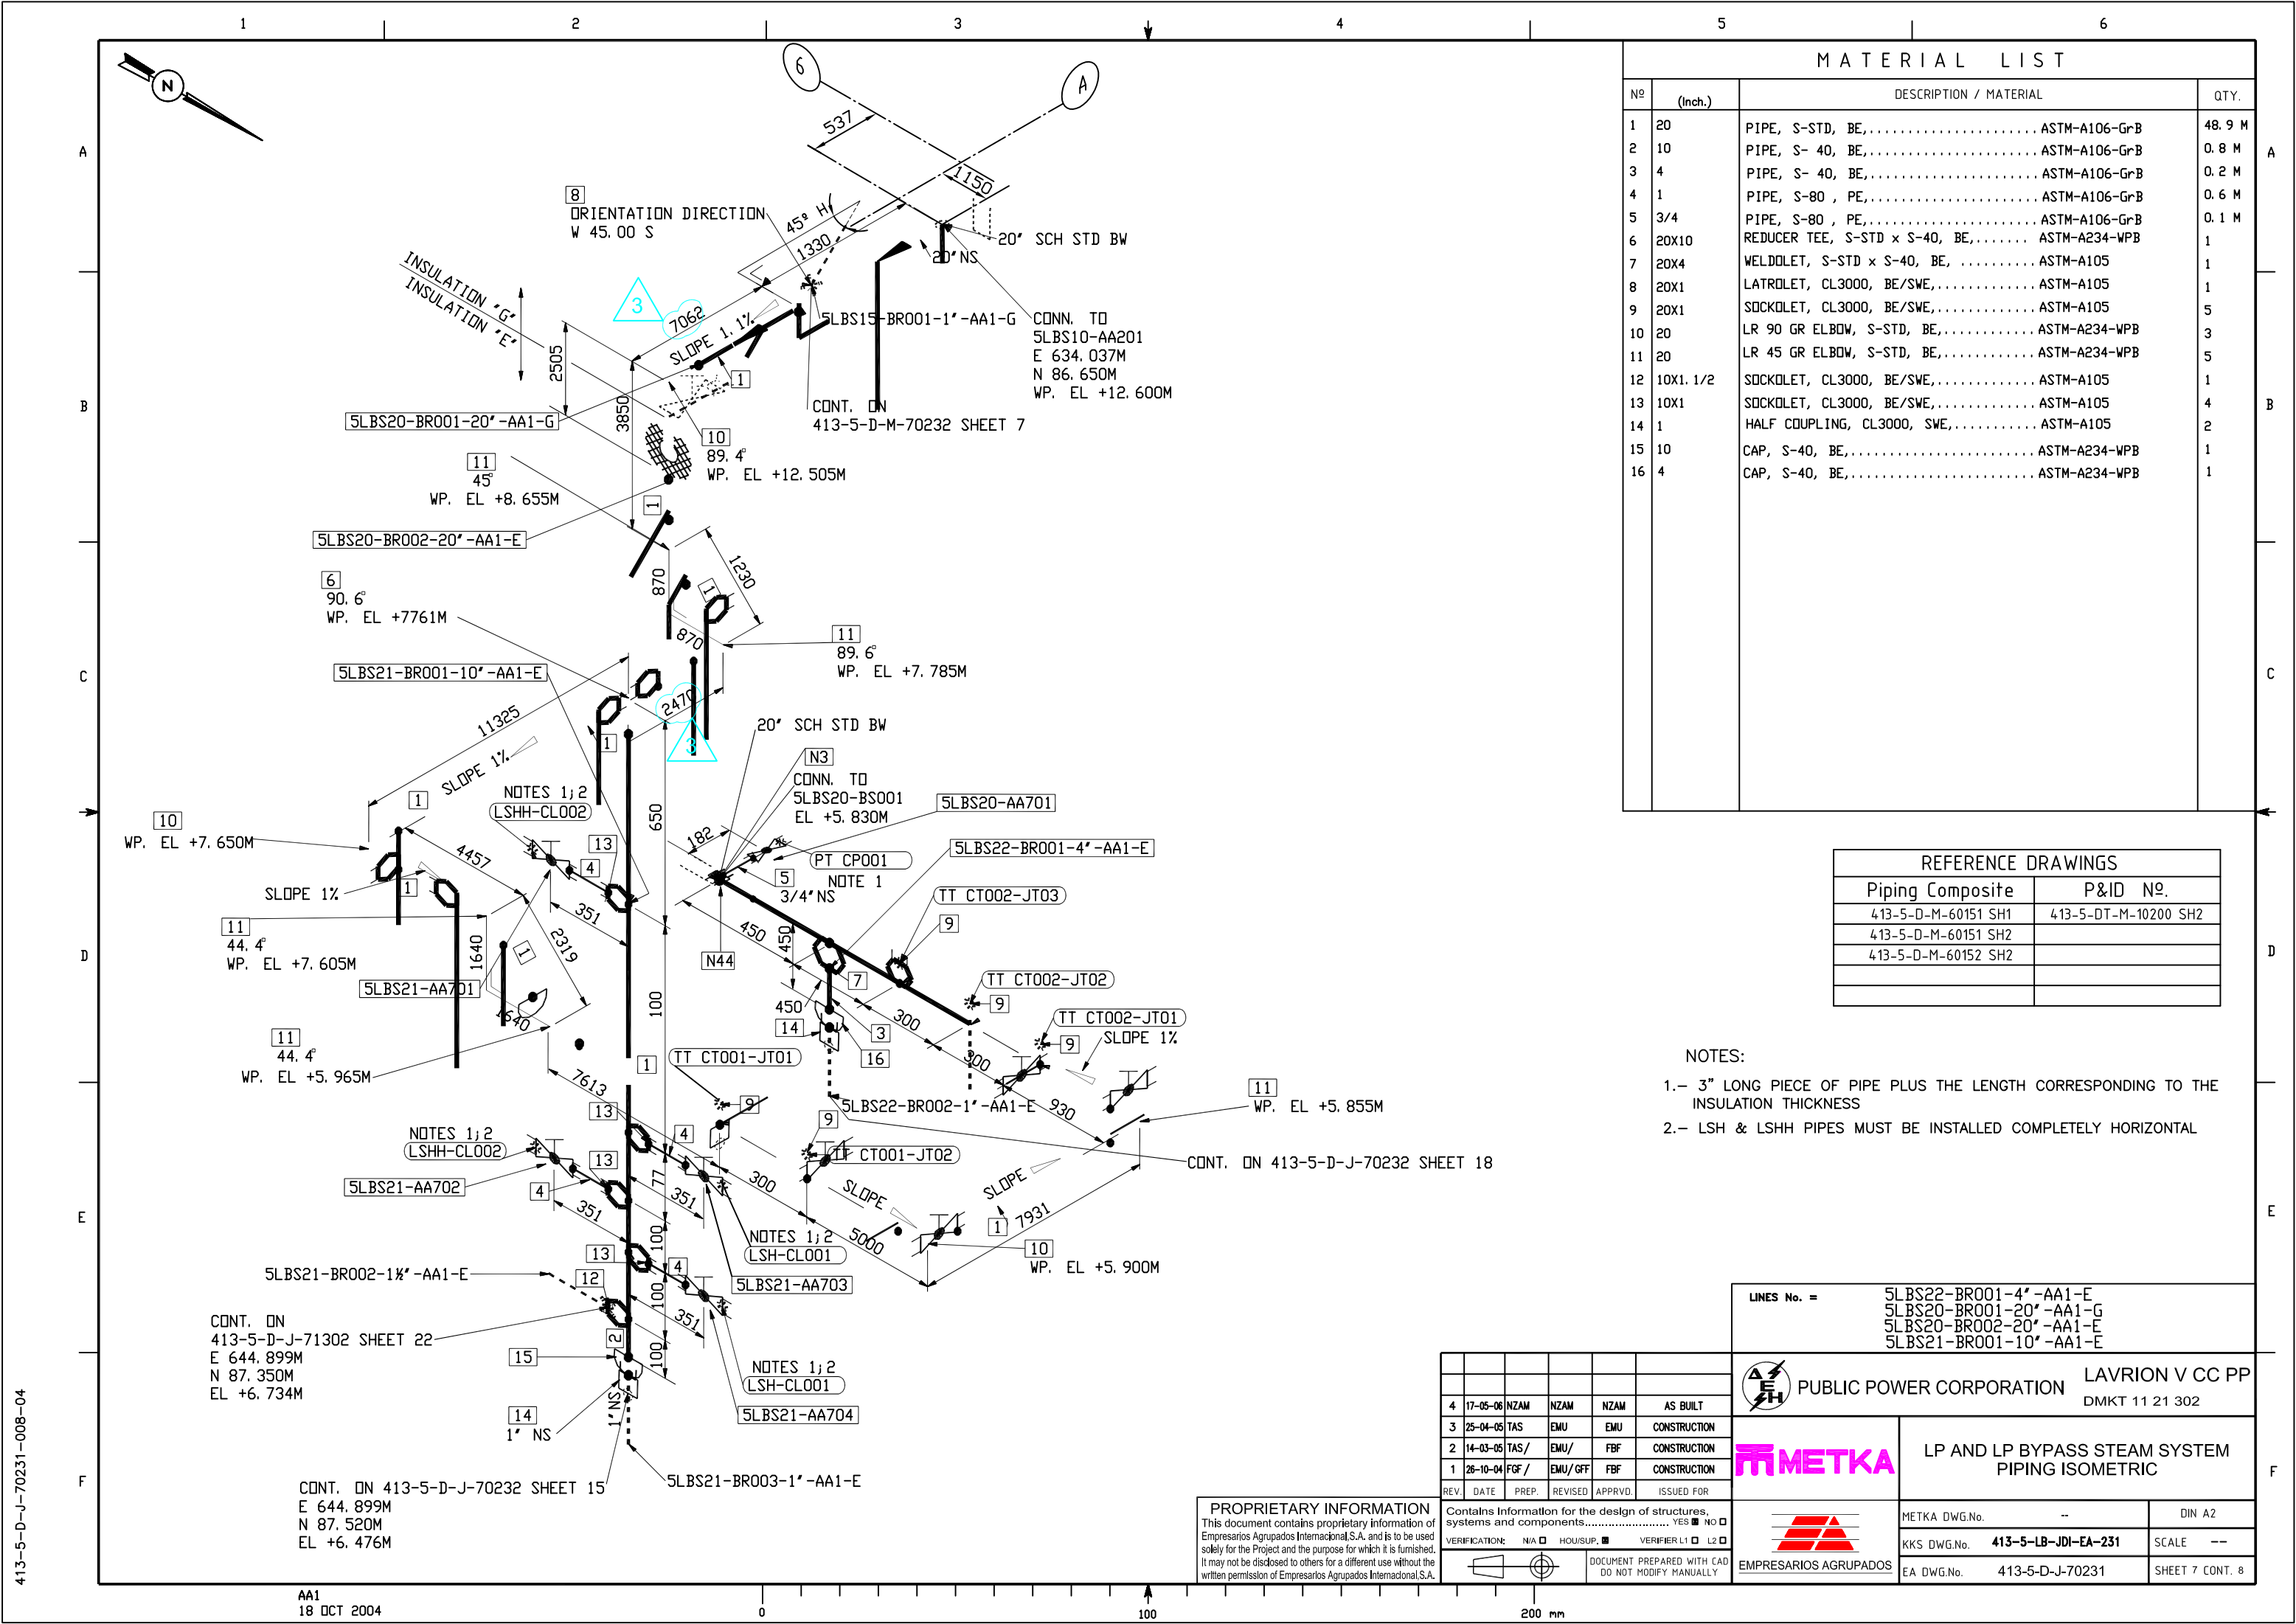

| MATERIAL LIST |           |                                                   |        |
|---------------|-----------|---------------------------------------------------|--------|
| Nº            | (Inch.)   | DESCRIPTION / MATERIAL                            | QTY.   |
| 1             | 20        | PIPE, S-STD, BE,..... ASTM-A106-GrB               | 48.9 M |
| 2             | 10        | PIPE, S- 40, BE,..... ASTM-A106-GrB               | 0.8 M  |
| 3             | 4         | PIPE, S- 40, BE,..... ASTM-A106-GrB               | 0.2 M  |
| 4             | 1         | PIPE, S-80 , PE,..... ASTM-A106-GrB               | 0.6 M  |
| 5             | 3/4       | PIPE, S-80 , PE,..... ASTM-A106-GrB               | 0.1 M  |
| 6             | 20X10     | REDUCER TEE, S-STD x S-40, BE,..... ASTM-A234-WPB | 1      |
| 7             | 20X4      | WELDOLET, S-STD x S-40, BE, ..... ASTM-A105       | 1      |
| 8             | 20X1      | LATROLET, CL3000, BE/SWE,..... ASTM-A105          | 1      |
| 9             | 20X1      | SOCKOLET, CL3000, BE/SWE,..... ASTM-A105          | 5      |
| 10            | 20        | LR 90 GR ELBOW, S-STD, BE,..... ASTM-A234-WPB     | 3      |
| 11            | 20        | LR 45 GR ELBOW, S-STD, BE,..... ASTM-A234-WPB     | 5      |
| 12            | 10X1. 1/2 | SOCKOLET, CL3000, BE/SWE,..... ASTM-A105          | 1      |
| 13            | 10X1      | SOCKOLET, CL3000, BE/SWE,..... ASTM-A105          | 4      |
| 14            | 1         | HALF COUPLING, CL3000, SWE,..... ASTM-A105        | 2      |
| 15            | 10        | CAP, S-40, BE,..... ASTM-A234-WPB                 | 1      |
| 16            | 4         | CAP, S-40, BE,..... ASTM-A234-WPB                 | 1      |

| REFERENCE DRAWINGS  |                      |
|---------------------|----------------------|
| Piping Composite    | P&ID Nº.             |
| 413-5-D-M-60151 SH1 | 413-5-DT-M-10200 SH2 |
| 413-5-D-M-60151 SH2 |                      |
| 413-5-D-M-60152 SH2 |                      |

- NOTES:
- 1.- 3" LONG PIECE OF PIPE PLUS THE LENGTH CORRESPONDING TO THE INSULATION THICKNESS
- 2.- LSH & LSHH PIPES MUST BE INSTALLED COMPLETELY HORIZONTAL

|                          |  |                                                                                                     |                     |
|--------------------------|--|-----------------------------------------------------------------------------------------------------|---------------------|
| LINES No. =              |  | 5LBS22-BR001-4'-AA1-E<br>5LBS20-BR001-20'-AA1-G<br>5LBS20-BR002-20'-AA1-E<br>5LBS21-BR001-10'-AA1-E |                     |
| PUBLIC POWER CORPORATION |  | LAVRION V CC PP<br>DMKT 11 21 302                                                                   |                     |
|                          |  | LP AND LP BYPASS STEAM SYSTEM<br>PIPING ISOMETRIC                                                   |                     |
|                          |  | METKA DWG.No.                                                                                       | DIN A2              |
|                          |  | KKS DWG.No.                                                                                         | 413-5-LB-JDI-EA-231 |
|                          |  | EA DWG.No.                                                                                          | 413-5-D-J-70231     |
|                          |  |                                                                                                     | SHEET 7 CONT. 8     |


| REV.                                                 | DATE     | PREP. | REVISED | APPRVD. | ISSUED FOR   |
|------------------------------------------------------|----------|-------|---------|---------|--------------|
| 4                                                    | 17-05-06 | NZAM  | NZAM    | NZAM    | AS BUILT     |
| 3                                                    | 25-04-05 | TAS   | EMU     | EMU     | CONSTRUCTION |
| 2                                                    | 14-03-05 | TAS/  | EMU/    | FBF     | CONSTRUCTION |
| 1                                                    | 26-10-04 | FCF/  | EMU/GFF | FBF     | CONSTRUCTION |
| DOCUMENT PREPARED WITH CAD<br>DO NOT MODIFY MANUALLY |          |       |         |         |              |

PROPRIETARY INFORMATION  
This document contains proprietary information of  
Empresarios Agrupados Internacional S.A. and is to be used  
solely for the Project and the purpose for which it is furnished.  
It may not be disclosed to others for a different use without the  
written permission of Empresarios Agrupados Internacional S.A.

413-5-D-J-70231-008-04





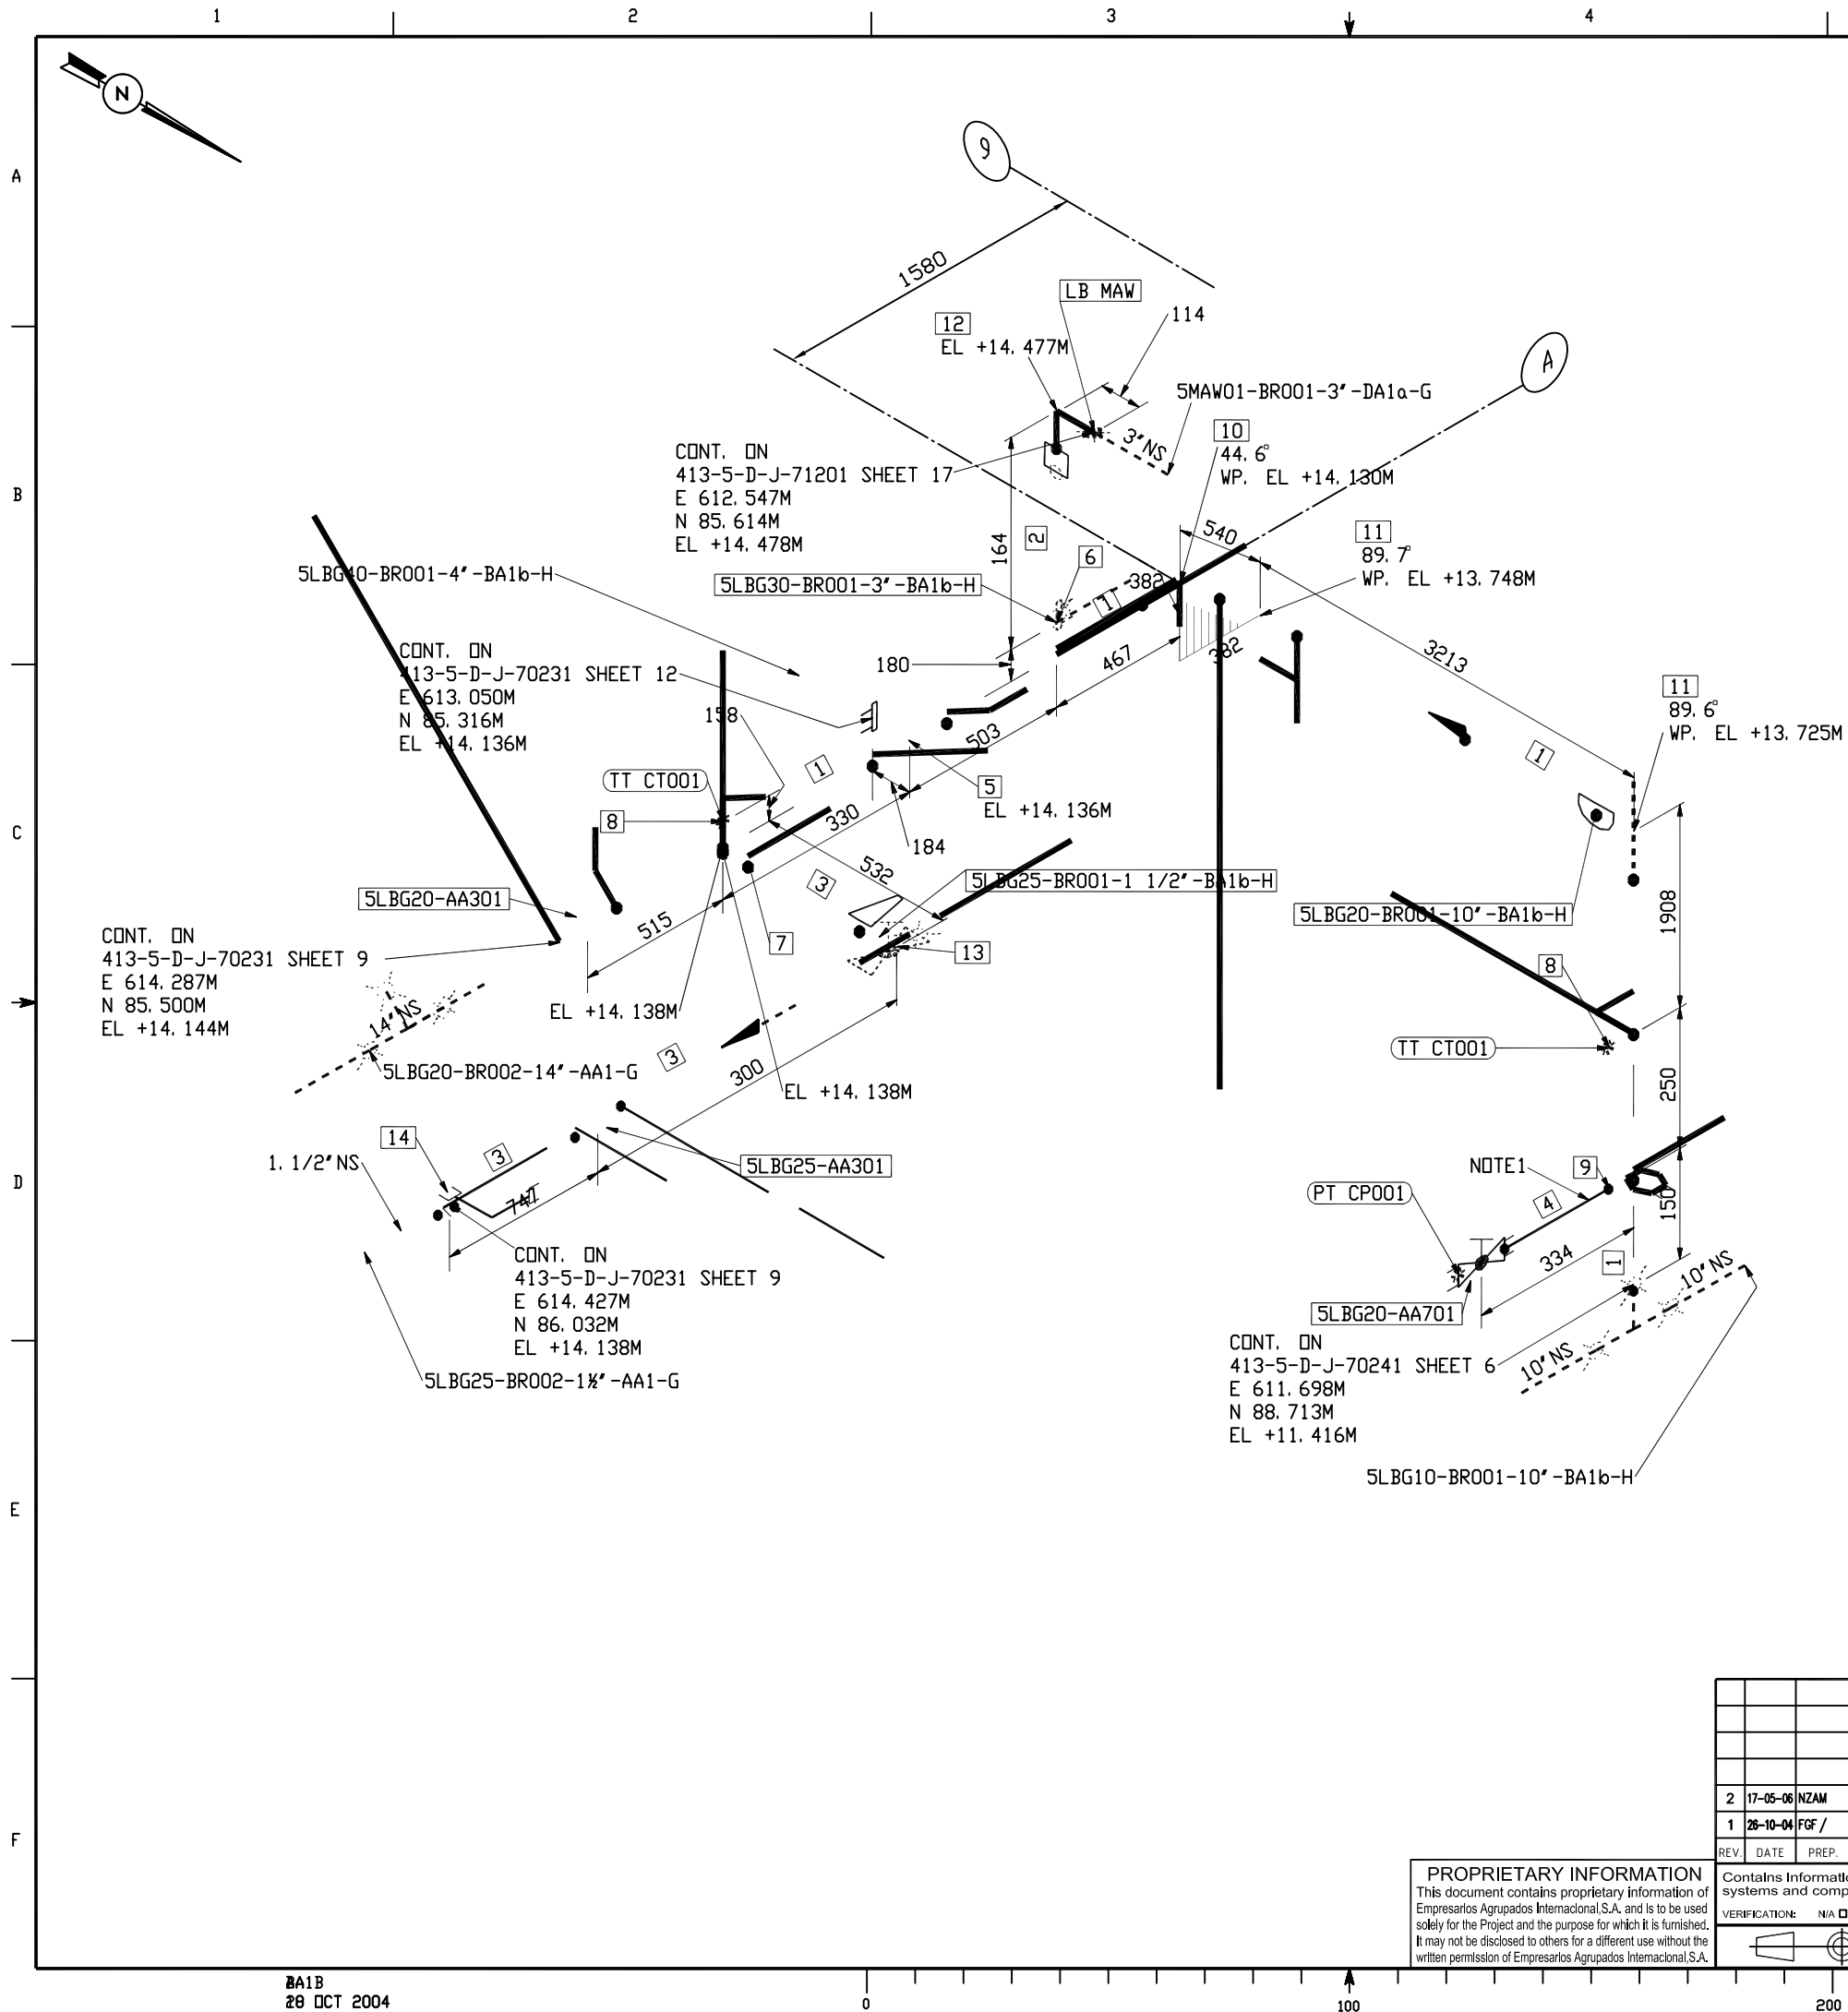

| MATERIAL LIST |          |                                                  |       |
|---------------|----------|--------------------------------------------------|-------|
| Nº            | (Inch.)  | DESCRIPTION / MATERIAL                           | QTY.  |
| 1             | 10       | PIPE, S-60, BE,..... ASTM-A106-GrB               | 5.3 M |
| 2             | 3        | PIPE, S-80, BE,..... ASTM-A106-GrB               | 0.1 M |
| 3             | 1.1/2    | PIPE, S-80, PE,..... ASTM-A106-GrB               | 1.3 M |
| 4             | 3/4      | PIPE, S-80, PE,..... ASTM-A106-GrB               | 0.2 M |
| 5             | 10X4     | REDUCER TEE, S-60 x S-80, BE,..... ASTM-A234-WPB | 1     |
| 6             | 10X3     | WELDOLET, S-60 x S-80, BE,..... ASTM-A105        | 1     |
| 7             | 10X1.1/2 | SOCKOLET, CL3000, BE/SWE,..... ASTM-A105         | 1     |
| 8             | 10X1     | SOCKOLET, CL3000, BE/SWE,..... ASTM-A105         | 2     |
| 9             | 10X3/4   | SOCKOLET, CL3000, BE/SWE,..... ASTM-A105         | 1     |
| 10            | 10       | LR 45 GR ELBOW, S-60, BE,..... ASTM-A234-WPB     | 1     |
| 11            | 10       | LR 90 GR ELBOW, S-60, BE,..... ASTM-A234-WPB     | 2     |
| 12            | 3        | LR 90 GR ELBOW, S-80, BE,..... ASTM-A234-WPB     | 1     |
| 13            | 1.1/2    | 90 GR ELBOW, CL3000, SWE,..... ASTM-A105         | 1     |
| 14            | 1.1/2    | FLANGE SW, CL300, RFFE/SWE,..... ASTM-A105       | 1     |


| REFERENCE DRAWINGS  |                      |
|---------------------|----------------------|
| Piping Composite    | P&ID Nº.             |
| 413-5-D-M-60152 SH2 | 413-5-DT-M-10200 SH2 |
|                     |                      |
|                     |                      |
|                     |                      |

- NOTES:
- 1.- 3" LONG PIECE OF PIPE PLUS THE LENGTH CORRESPONDING TO THE INSULATION THICKNESS
  - 2.- THE LENGTHS OF THE STRAIGHT PIPE SECTIONS HAVE BEEN OBTAINED TAKING INTO ACCOUNT THE DISTANCE BETWEEN VALVE FACES ACCORDING TO STANDARD ANSI B16.10 FINAL DIMENSION SHALL BE DEFINED BY THE FABRICATOR BASED ON VALVE SUPPLIER DRAWINGS.


PROPRIETARY INFORMATION  
This document contains proprietary information of  
Empresarios Agrupados Internacional S.A. and is to be used  
solely for the Project and the purpose for which it is furnished.  
It may not be disclosed to others for a different use without the  
written permission of Empresarios Agrupados Internacional S.A.

|      |          |       |           |          |              |
|------|----------|-------|-----------|----------|--------------|
| 2    | 17-05-06 | NZAM  | NZAM      | NZAM     | AS BUILT     |
| 1    | 26-10-04 | FCF / | EMU / GFF | FBF      | CONSTRUCTION |
| REV. | DATE     | PREP. | REVISED   | APPROVD. | ISSUED FOR   |
|      |          |       |           |          |              |
|      |          |       |           |          |              |
|                                                                                                                                                  |                   |
|--------------------------------------------------------------------------------------------------------------------------------------------------|-------------------|
| LINES No. = 5LBG20-BR001-10'-BA1b-H<br>5LBG30-BR001-3'-BA1b-H<br>5LBG25-BR001-1½'-BA1b-H                                                         |                   |
|  PUBLIC POWER CORPORATION LAVRION V CC PP<br>DMKT 11 21 302 |                   |
|  LP AND LP BYPASS STEAM SYSTEM<br>PIPING ISOMETRIC          |                   |
| METKA DWG.No. --                                                                                                                                 | DIN A2            |
| KKS DWG.No. 413-5-LB-JDI-EA-231                                                                                                                  | SCALE --          |
| EA DWG.No. 413-5-D-J-70231                                                                                                                       | SHEET 10 CONT. 11 |

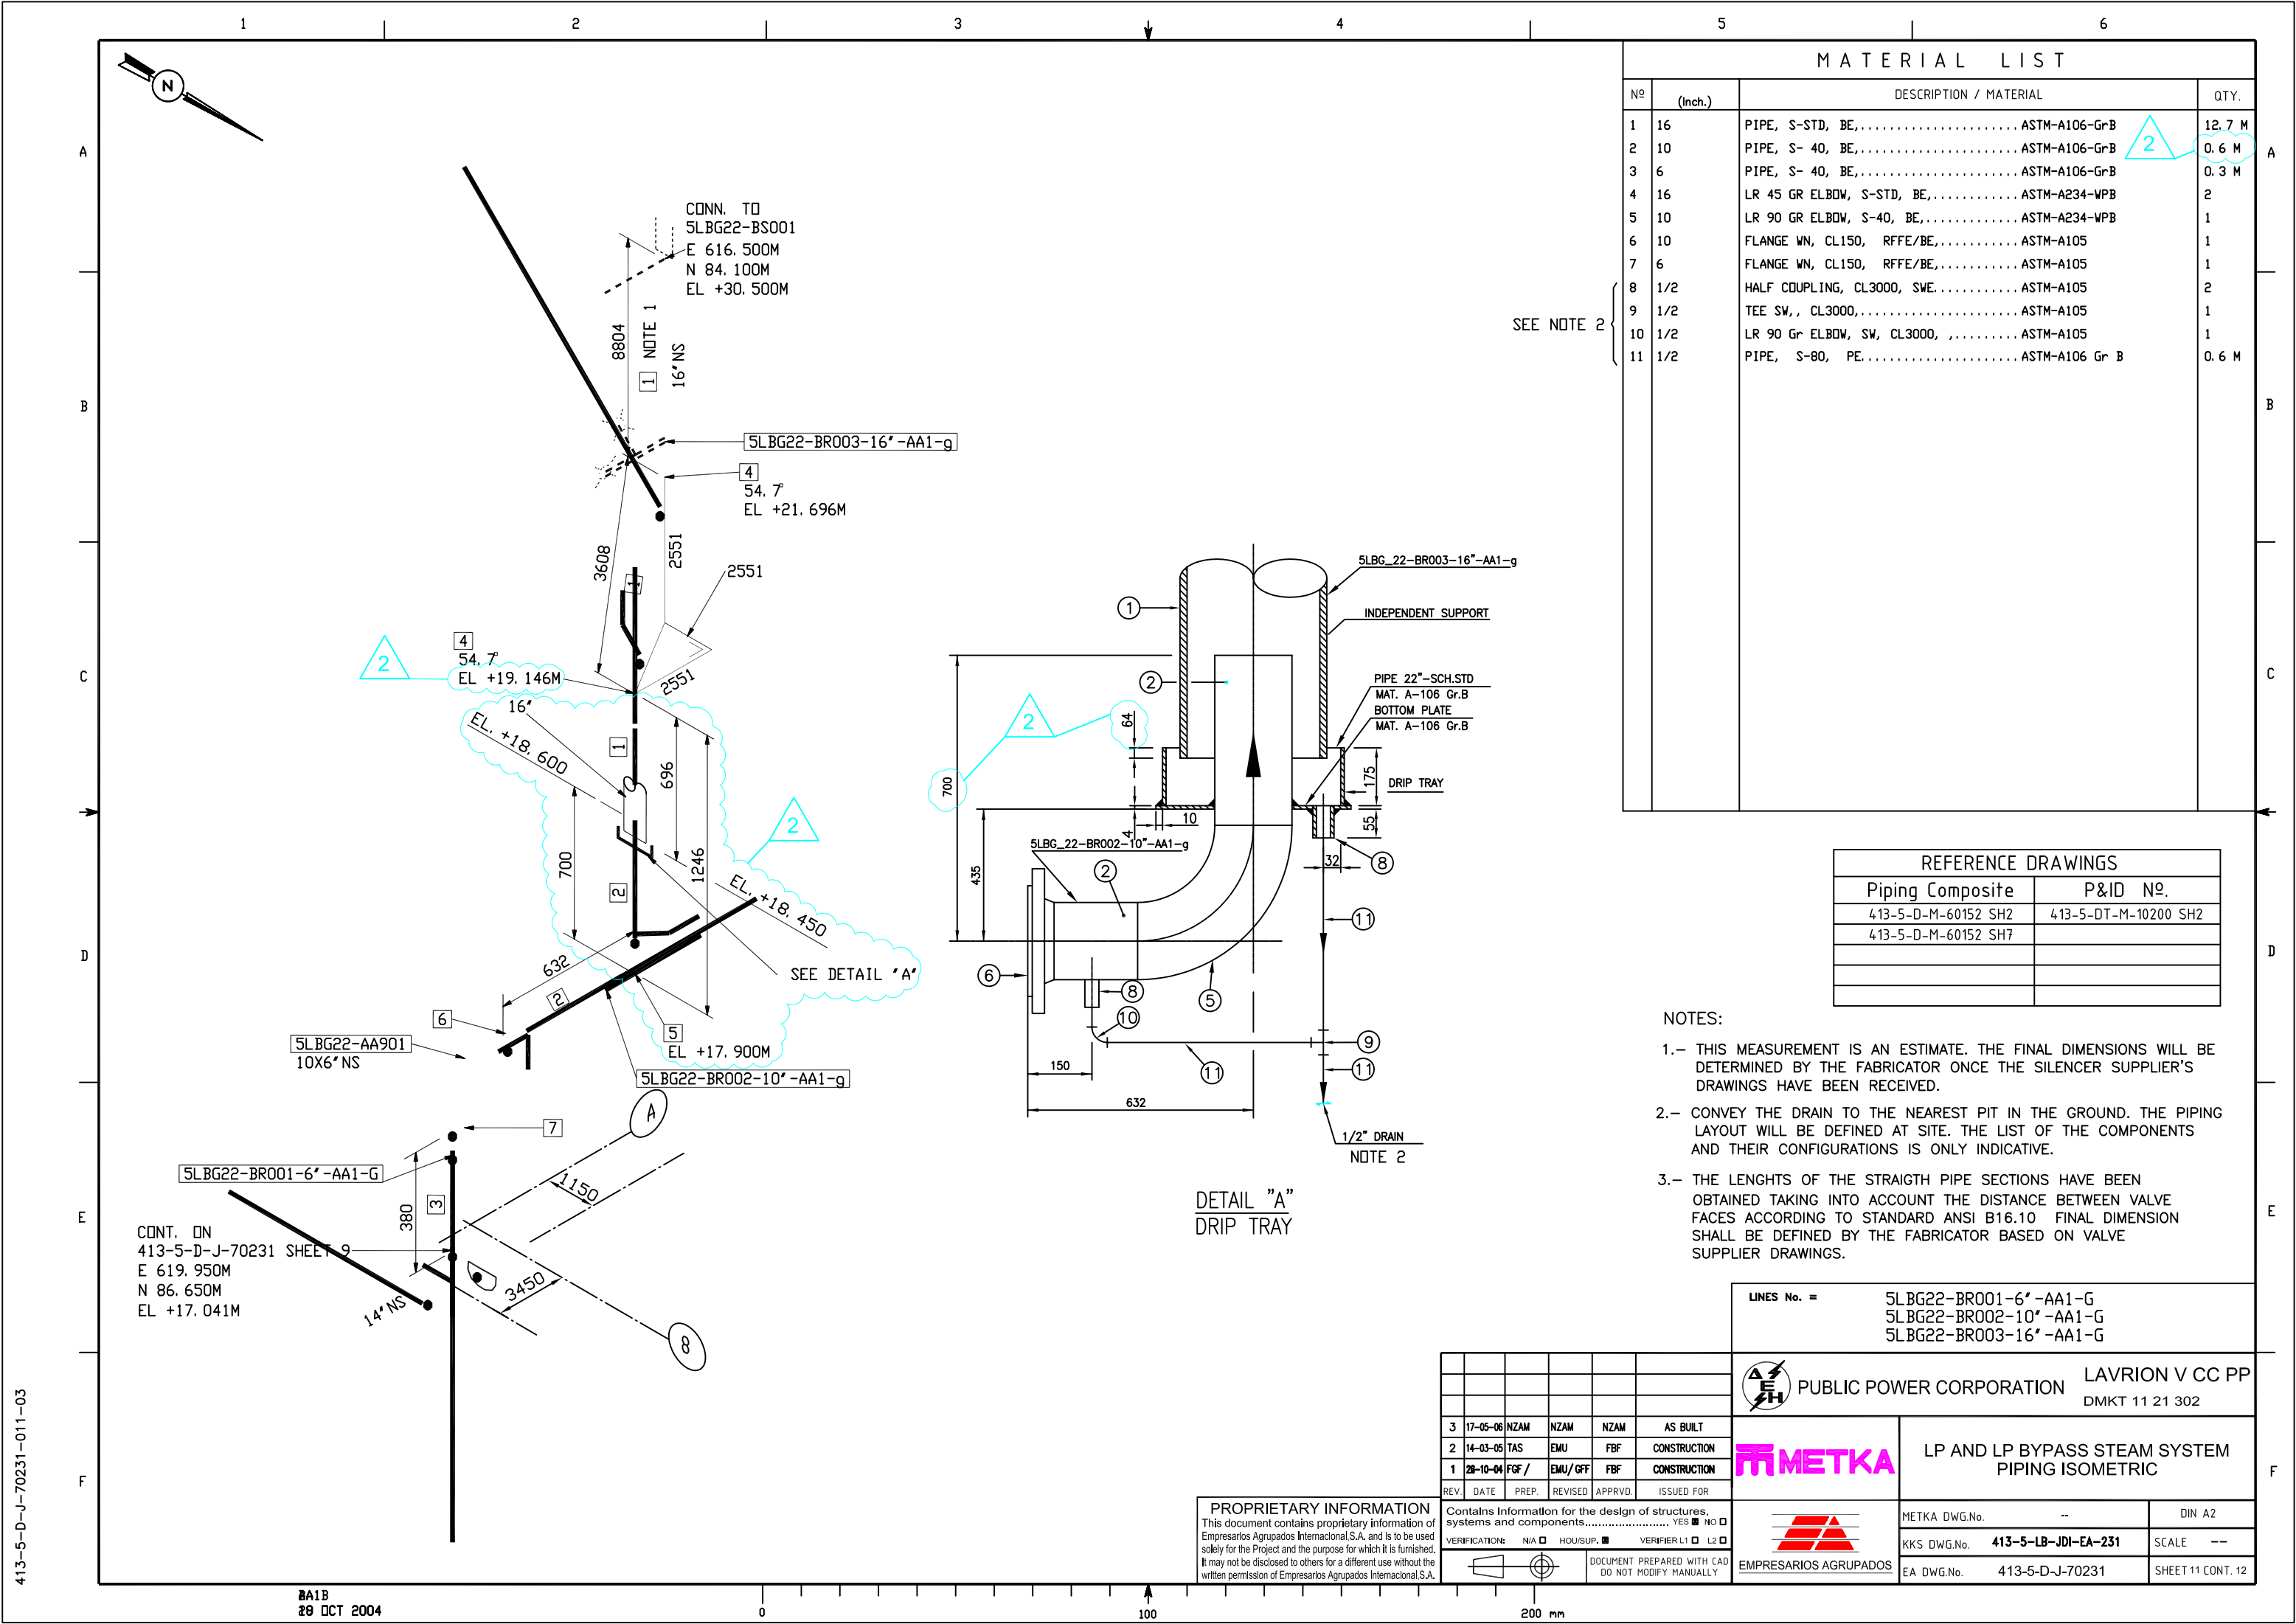

| MATERIAL LIST |         |                                              |        |   |
|---------------|---------|----------------------------------------------|--------|---|
| Nº            | (Inch.) | DESCRIPTION / MATERIAL                       | QTY.   |   |
| 1             | 16      | PIPE, S-STD, BE,.....ASTM-A106-GrB           | 12.7 M | A |
| 2             | 10      | PIPE, S- 40, BE,.....ASTM-A106-GrB           | 0.6 M  |   |
| 3             | 6       | PIPE, S- 40, BE,.....ASTM-A106-GrB           | 0.3 M  |   |
| 4             | 16      | LR 45 GR ELBOW, S-STD, BE,.....ASTM-A234-WPB | 2      | B |
| 5             | 10      | LR 90 GR ELBOW, S-40, BE,.....ASTM-A234-WPB  | 1      |   |
| 6             | 10      | FLANGE WN, CL150, RFFE/BE,.....ASTM-A105     | 1      |   |
| 7             | 6       | FLANGE WN, CL150, RFFE/BE,.....ASTM-A105     | 1      | C |
| 8             | 1/2     | HALF COUPLING, CL3000, SWE.....ASTM-A105     | 2      |   |
| 9             | 1/2     | TEE SW,, CL3000,.....ASTM-A105               | 1      |   |
| 10            | 1/2     | LR 90 Gr ELBOW, SW, CL3000, ,.....ASTM-A105  | 1      | D |
| 11            | 1/2     | PIPE, S-80, PE.....ASTM-A106 Gr B            | 0.6 M  |   |

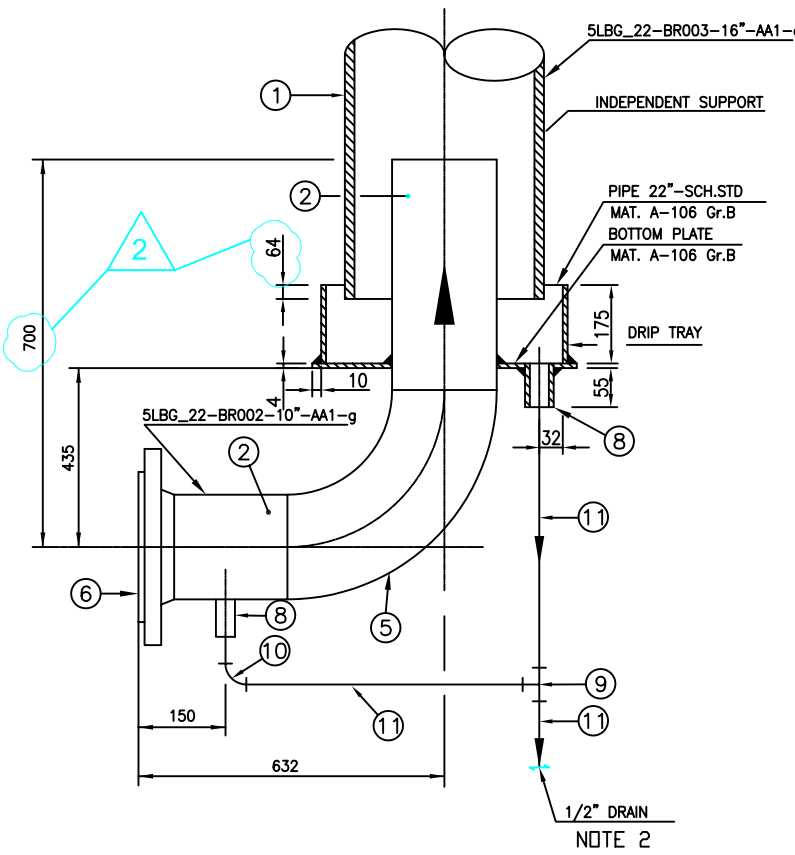

| REFERENCE DRAWINGS  |                      |
|---------------------|----------------------|
| Piping Composite    | P&ID Nº.             |
| 413-5-D-M-60152 SH2 | 413-5-DT-M-10200 SH2 |
| 413-5-D-M-60152 SH7 |                      |
|                     |                      |
|                     |                      |

- NOTES:
- 1.- THIS MEASUREMENT IS AN ESTIMATE. THE FINAL DIMENSIONS WILL BE DETERMINED BY THE FABRICATOR ONCE THE SILENCER SUPPLIER'S DRAWINGS HAVE BEEN RECEIVED.
  - 2.- CONVEY THE DRAIN TO THE NEAREST PIT IN THE GROUND. THE PIPING LAYOUT WILL BE DEFINED AT SITE. THE LIST OF THE COMPONENTS AND THEIR CONFIGURATIONS IS ONLY INDICATIVE.
  - 3.- THE LENGHTS OF THE STRAIGHT PIPE SECTIONS HAVE BEEN OBTAINED TAKING INTO ACCOUNT THE DISTANCE BETWEEN VALVE FACES ACCORDING TO STANDARD ANSI B16.10 FINAL DIMENSION SHALL BE DEFINED BY THE FABRICATOR BASED ON VALVE SUPPLIER DRAWINGS.

LINES No. = 5L BG22-BR001-6'-AA1-G  
5L BG22-BR002-10'-AA1-G  
5L BG22-BR003-16'-AA1-G

 PUBLIC POWER CORPORATION LAVRION V CC PP  
DMKT 11 21 302

 LP AND LP BYPASS STEAM SYSTEM  
PIPING ISOMETRIC

|               |                     |                   |
|---------------|---------------------|-------------------|
| METKA DWG.No. | --                  | DIN A2            |
| KKS DWG.No.   | 413-5-LB-JDI-EA-231 | SCALE --          |
| EA DWG.No.    | 413-5-D-J-70231     | SHEET 11 CONT. 12 |

| REV. | DATE     | PREP. | REVISED | APPRVD. | ISSUED FOR   |
|------|----------|-------|---------|---------|--------------|
| 3    | 17-05-06 | NZAM  | NZAM    | NZAM    | AS BUILT     |
| 2    | 14-03-05 | TAS   | EMU     | FBF     | CONSTRUCTION |
| 1    | 28-10-04 | FCF / | EMU/GFF | FBF     | CONSTRUCTION |

**PROPRIETARY INFORMATION**  
This document contains proprietary information of Empresarios Agrupados Internacional,S.A. and is to be used solely for the Project and the purpose for which it is furnished. It may not be disclosed to others for a different use without the written permission of Empresarios Agrupados Internacional,S.A.


Contains Information for the design of structures, systems and components..... YES ☒ NO ☐

VERIFICATION: N/A ☐ HOUSEHOLD ☒ VERIFIER L1 ☐ L2 ☐


DOCUMENT PREPARED WITH CAD DO NOT MODIFY MANUALLY

413-5-D-J-70231-011-03

413-5-D-J-70231-012-02

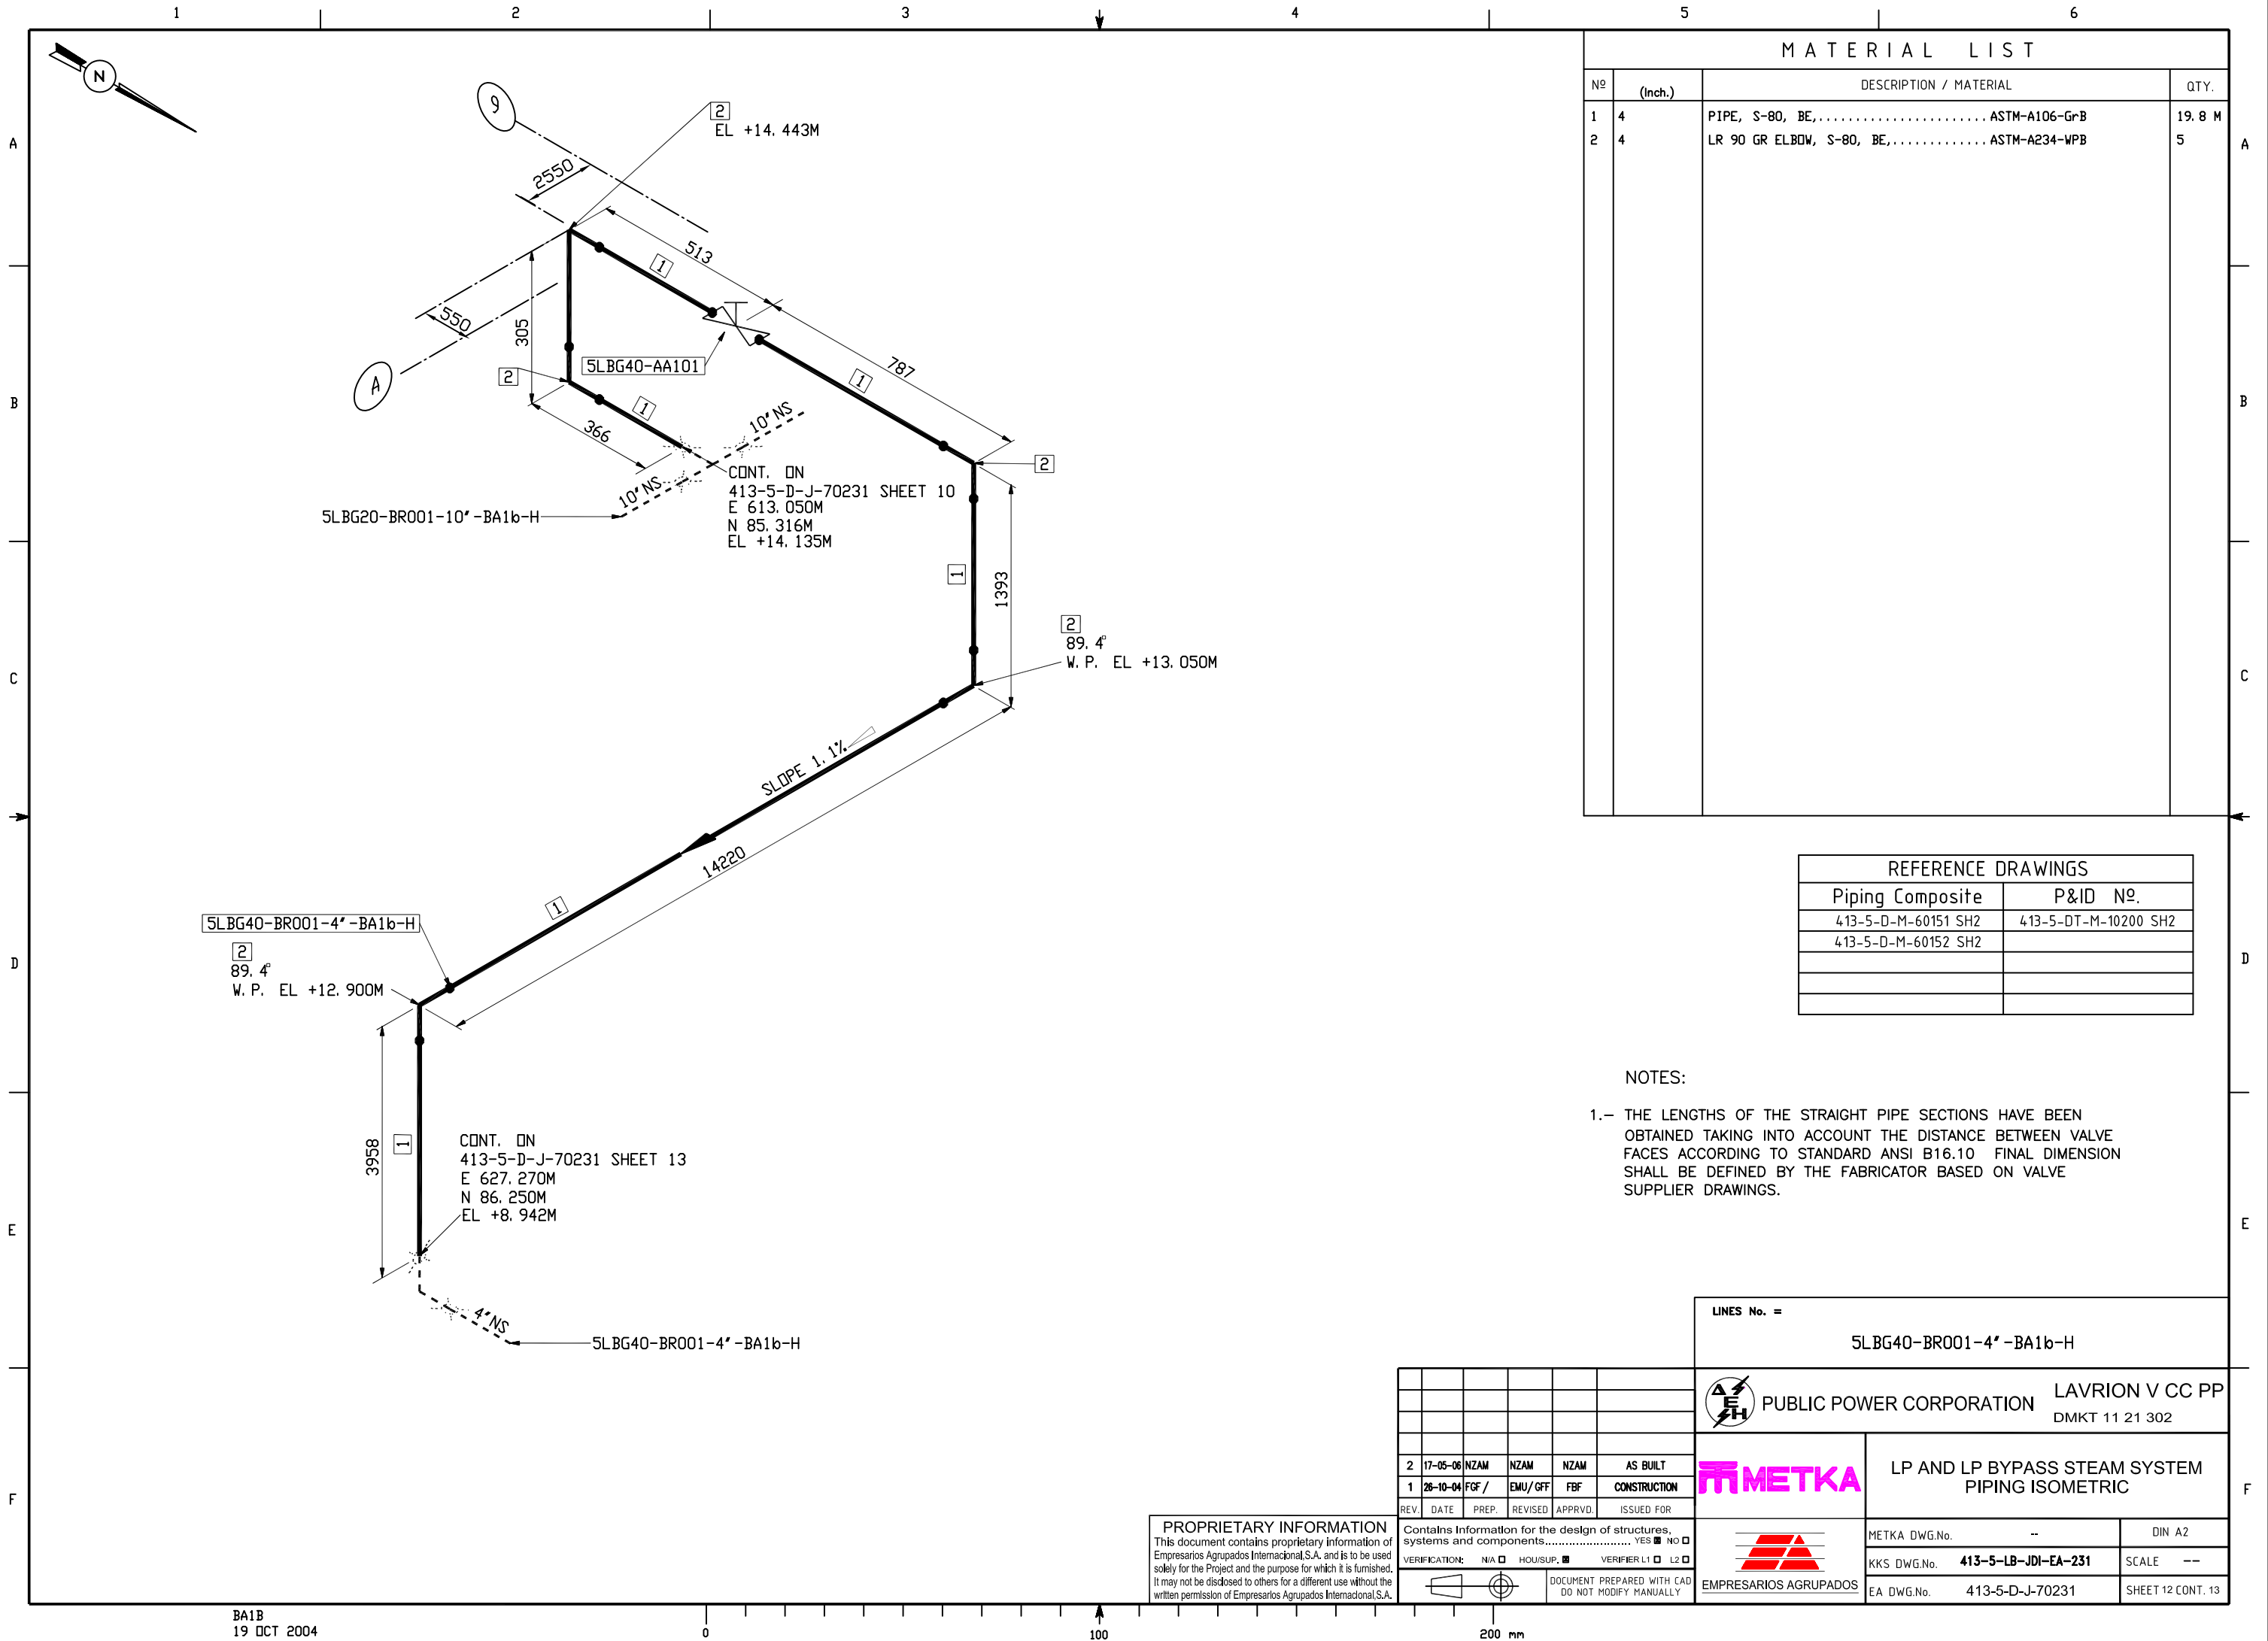


413-5-d-j-70231-013-02

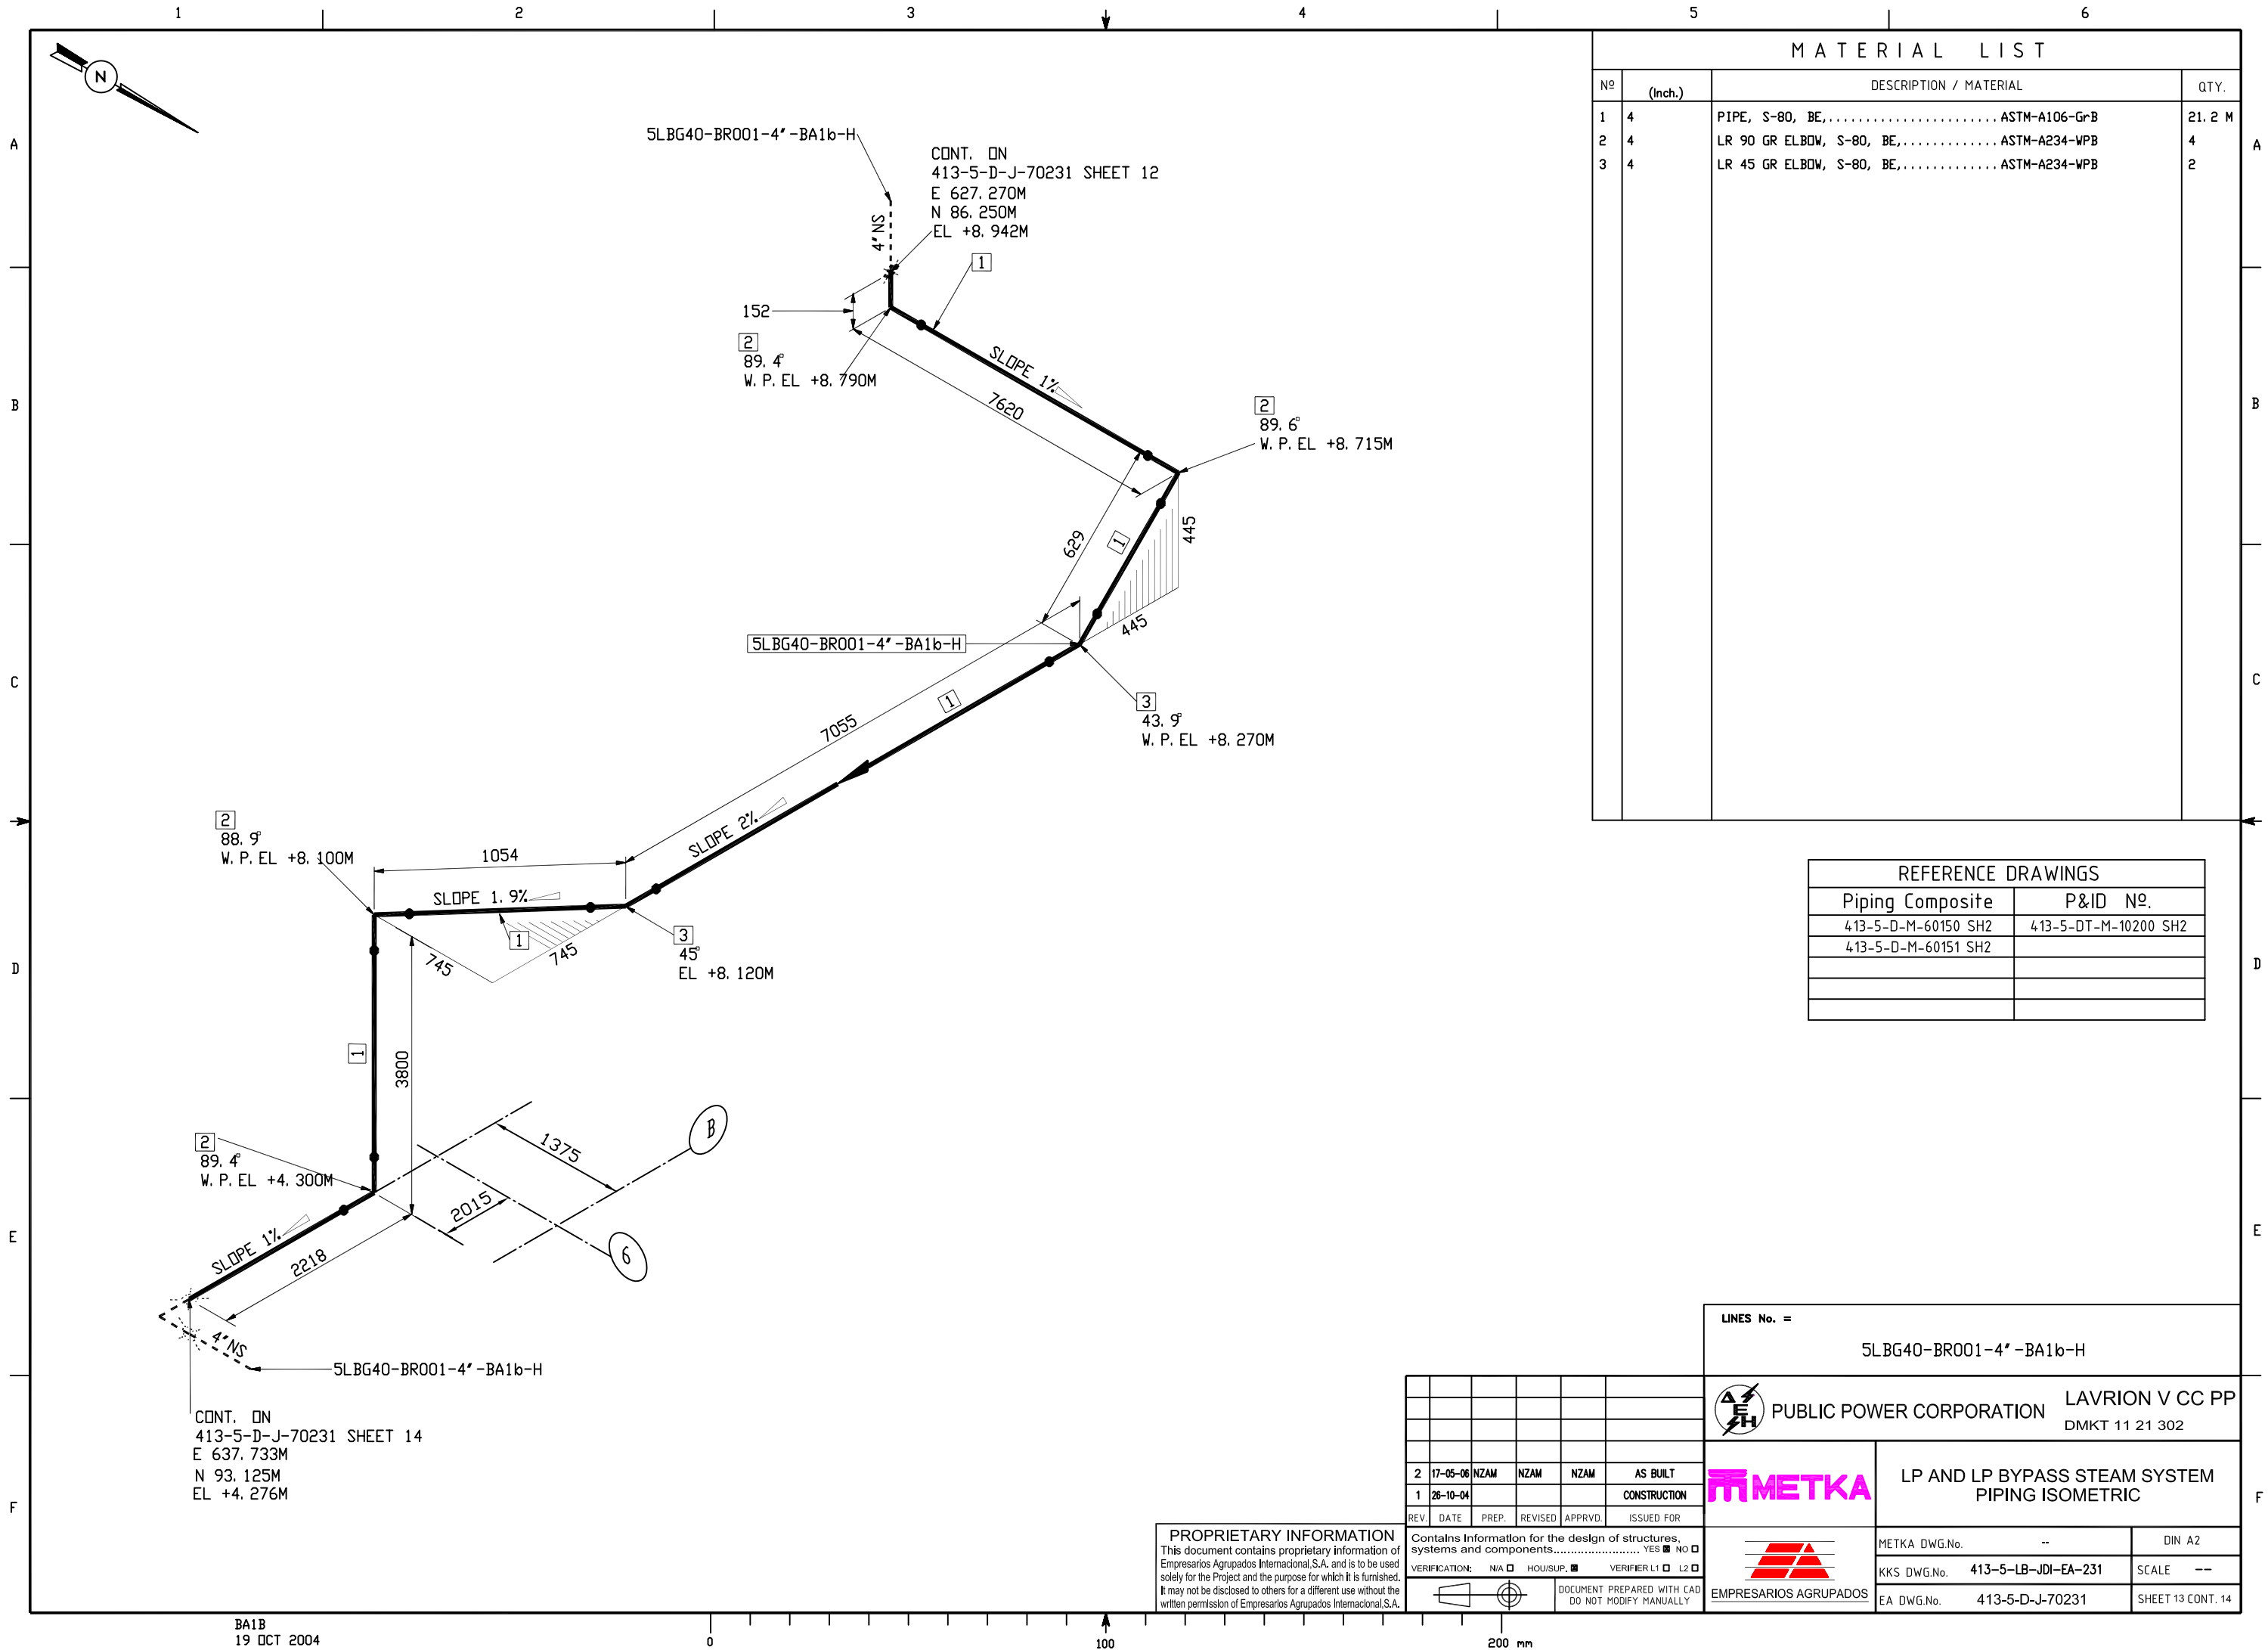






413-5-D-J-70231-015-02

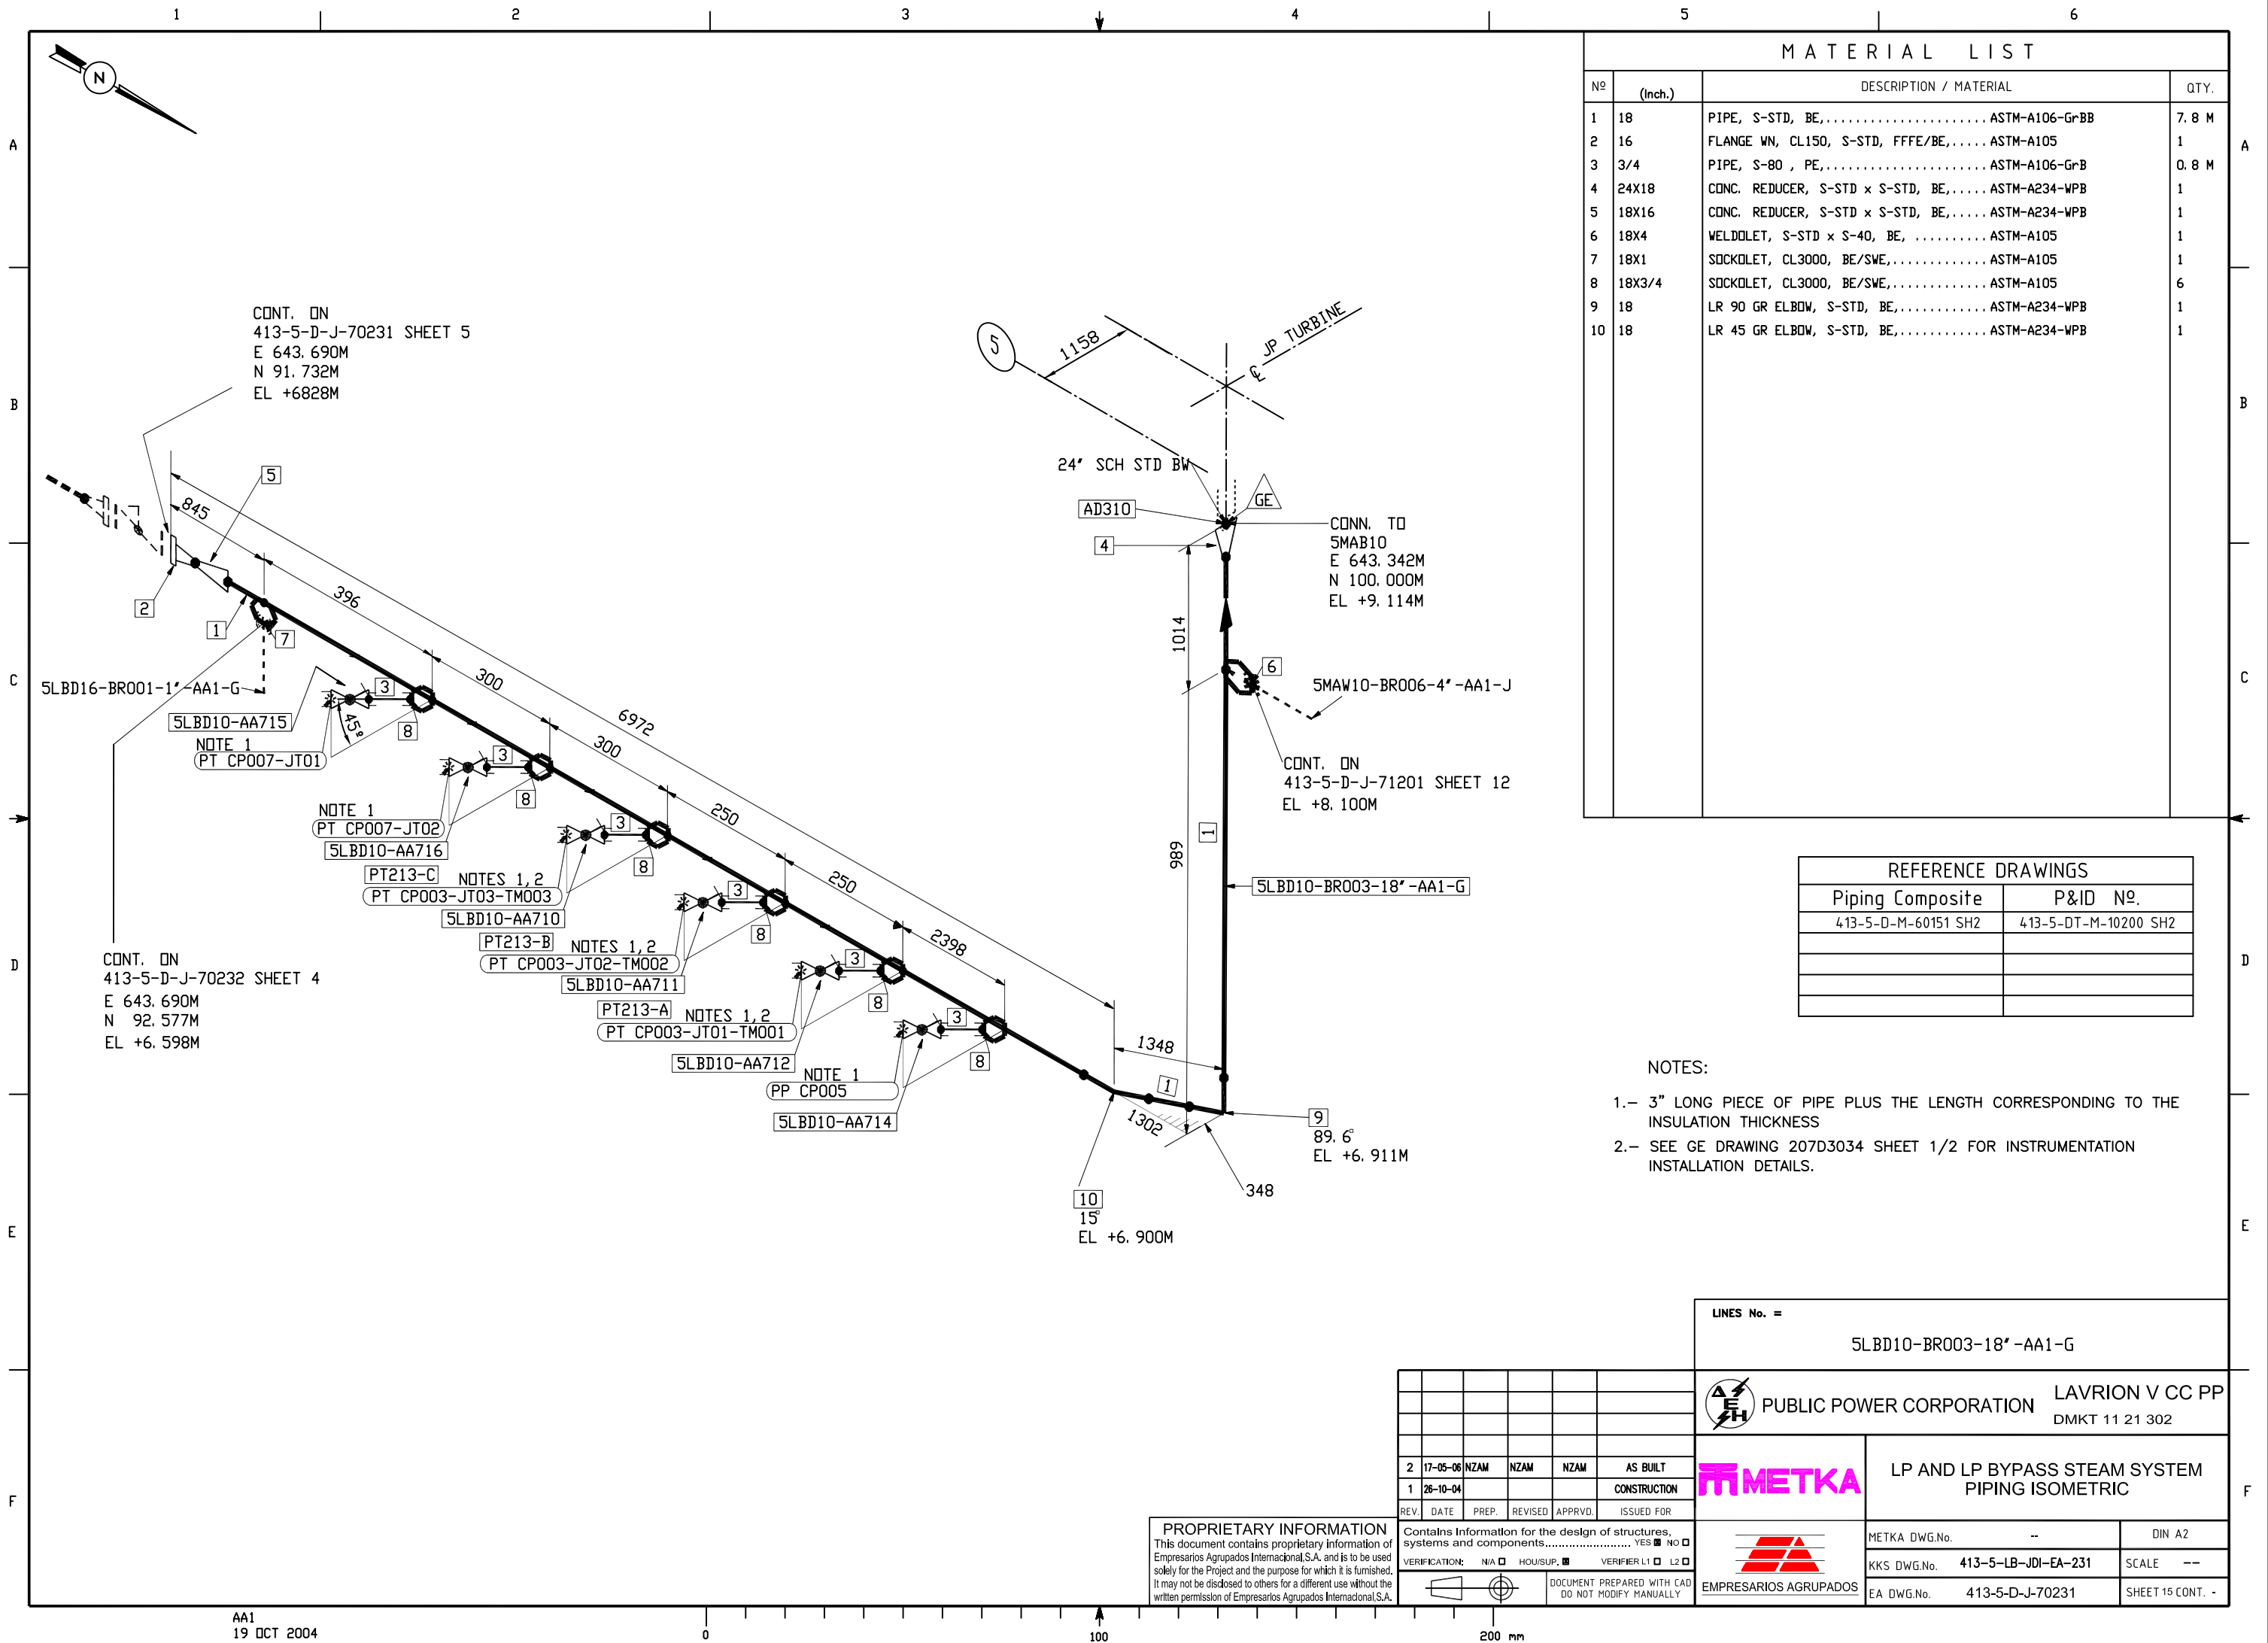

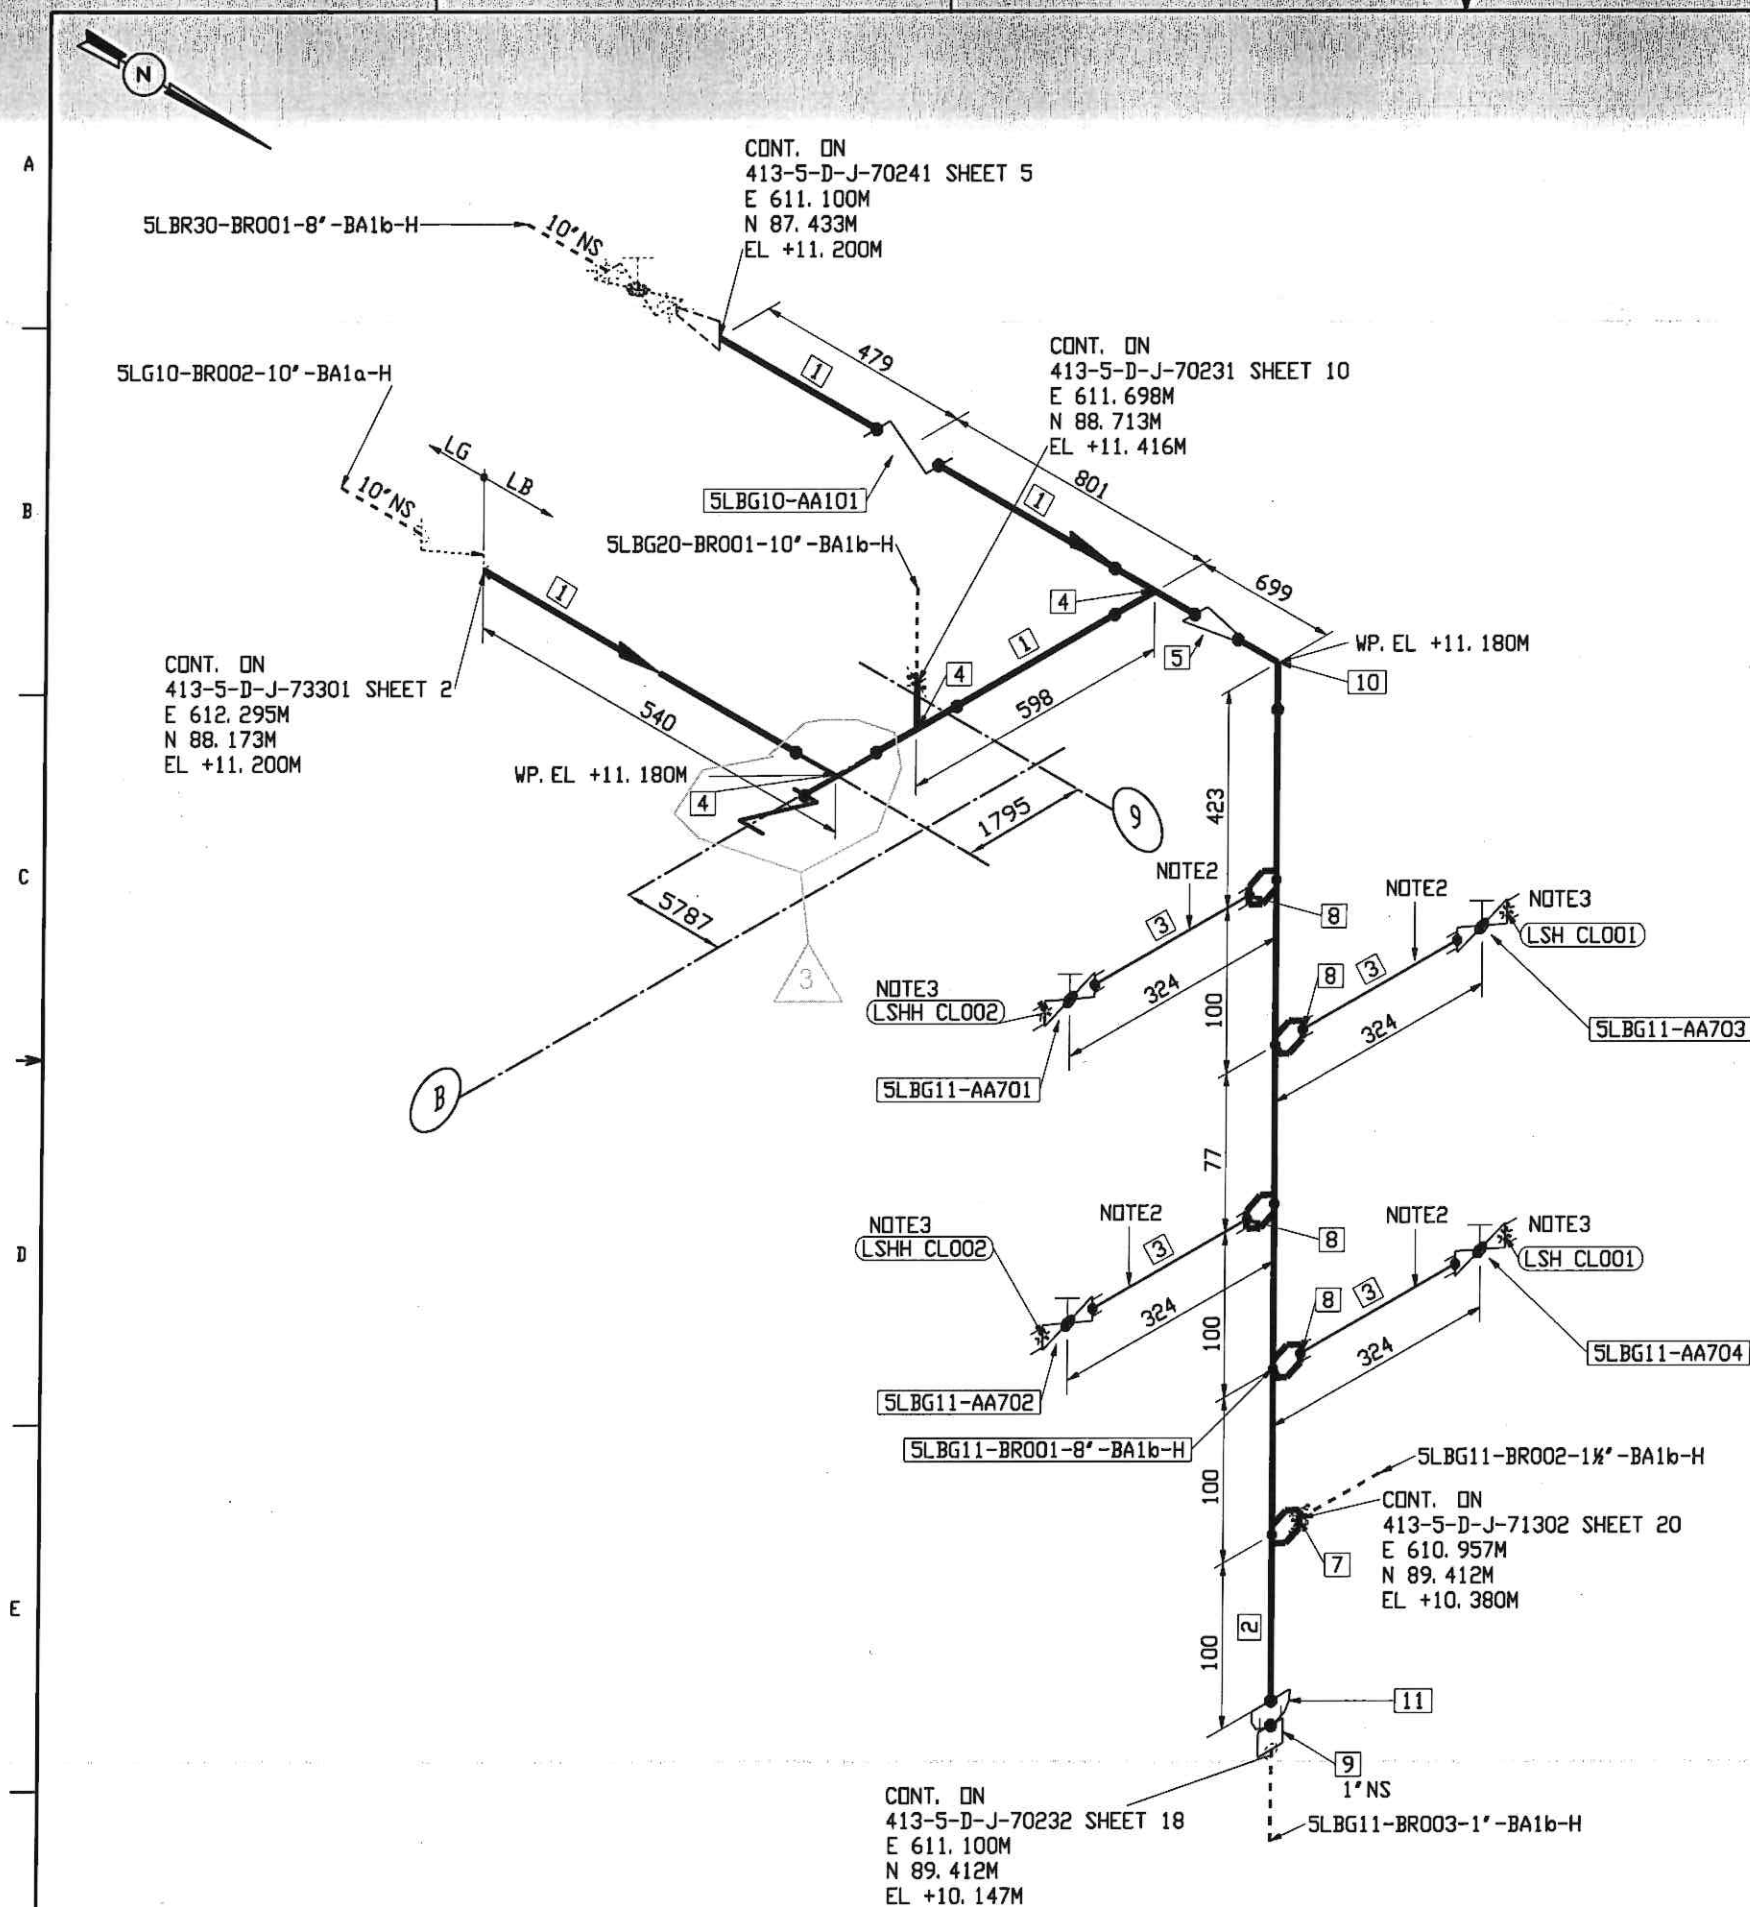

## MATERIAL LIST

| Nº | Size (Inch.) | DESCRIPTION / MATERIAL                            | QTY.  |
|----|--------------|---------------------------------------------------|-------|
| 1  | 10           | PIPE, S-60, BE,.....ASTM-A106-GrB                 | 0.8 M |
| 2  | 8            | PIPE, S-60, BE,.....ASTM-A106-GrB                 | 0.6 M |
| 3  | 1            | PIPE, S-80, PE,.....ASTM-A106-GrB                 | 0.6 M |
| 4  | 10X10        | TEE, S-60, BE,.....ASTM-A234-WPB                  | 3     |
| 5  | 10X8         | CONC. REDUCER, S-60 x S-60, BE,.....ASTM-A234-WPB | 1     |
| 7  | 8X1.1/2      | SOCKET, CL3000, BE/SWE,.....ASTM-A105             | 1     |
| 8  | 8X1          | SOCKET, CL3000, BE/SWE,.....ASTM-A105             | 4     |
| 9  | 1            | HALF COUPLING, CL3000, SWE,.....ASTM-A105         | 1     |
| 11 | 8            | CAP, S-60, BE,.....ASTM-A234-WPB                  | 1     |

## REFERENCE DRAWINGS

| Piping Composite    | P&ID N°.             |
|---------------------|----------------------|
| 413-5-D-M-60152 SH2 | 413-5-DT-M-10200 SH2 |
|                     |                      |
|                     |                      |
|                     |                      |

## NOTES:

- 1.- THE LENGTHS OF THE STRAIGHT PIPE SECTIONS HAVE BEEN OBTAINED TAKING INTO ACCOUNT THE DISTANCE BETWEEN VALVE FACES ACCORDING TO STANDARD ANSI B16.10 FINAL DIMENSION SHALL BE DEFINED BY THE FABRICATOR BASED ON VALVE SUPPLIER DRAWINGS.
- 2.- 3" LONG PIECE OF PIPE PLUS THE LENGTH CORRESPONDING TO THE INSULATION THICKNESS
- 3.- LSH & LSHH PIPES MUST BE INSTALLED COMPLETELY HORIZONTAL

LINES No. =  
 5LBG10-BR001-10'-BA1b-H  
 5LBG11-BR001-8'-BA1b-H



PUBLIC POWER CORPORATION LAVRION V CC PP  
 DMKT 11 21 302

**METKA**


IP BYPASS STEAM SYSTEM  
 PIPING ISOMETRIC

METKA DWG.No. - DIN A2  
 KKS DWG.No. 413-5-LB-JDI-EA-241 SCALE -  
 EA DWG.No. 413-5-D-J-70241 SHEET 6 CONT. -

**PROPRIETARY INFORMATION**  
 This document contains proprietary information of Empresarios Agrupados Internacional, S.A. and is to be used solely for the Project and the purpose for which it is furnished. It may not be disclosed to others for a different use without the written permission of Empresarios Agrupados Internacional, S.A.

| REV. | DATE     | PREP. | REVISED   | APPROV. | ISSUED FOR   |
|------|----------|-------|-----------|---------|--------------|
| 3    | 18-05-08 | NZAM  | NZAM      | NZAM    | AS BUILT     |
| 2    | 11-03-05 | TAS   | EMU       | FBF     | CONSTRUCTION |
| 1    | 29-10-04 | FGF / | EMU / GFF | FBF     | CONSTRUCTION |

Contains information for the design of structures, systems and components. YES ☐ NO ☐  
 VERIFICATION: N/A ☐ JUD/SUP. ☐ VERIFIER N1 ☐ N2 ☐  
 DOCUMENT PREPARED WITH CAD DO NOT MODIFY MANUALLY.

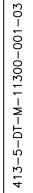

|                                                                                                                       |               |                             |              |
|-----------------------------------------------------------------------------------------------------------------------|---------------|-----------------------------|--------------|
| <br><b>EMPRESARIOS AGRUPADOS</b> | METKA DWG.No. | —                           | DIN A0       |
|                                                                                                                       | KKS DWG.No.   | <b>413-5-MAL-MDD-EA-300</b> | SCALE —      |
|                                                                                                                       | EA DWG.No.    | 413-5-DT-M-11300            | SHEET 1 OF 2 |

**PROPRIETARY INFORMATION**  
This document contains proprietary information of Empresas Agrupadas Internacional S.A. and is to be used solely for the Project and the purpose for which it is furnished. It may not be disclosed to others for a different use without the written permission of Empresas Agrupadas Internacional S.A.

|      |          |       |         |         |              |
|------|----------|-------|---------|---------|--------------|
|      |          |       |         |         |              |
| 3    | 08-05-06 | ESO   | DGG/    |         | AS-BUILT     |
| 2    | 15-10-04 | ESO/  | DGG     | VAJ     | CONSTRUCTION |
| 1    | 29-03-04 | ESO/  | DGG     | VAJ     | DESIGN       |
| REV. | DATE     | PREP. | REVISED | APPROV. | ISSUED FOR   |

Contains information for the design of structures, systems and components..... YES ☒ NO ☐

VERIFICATION: N/A ☐ HOUSEP. ☒ VERIFIER L1 ☐ L2 ☐




DOCUMENT PREPARED WITH CA  
DO NOT MODIFY MANUALLY



P&ID  
STEAM TURBINE DRAINS AND VENTS SYSTEM

|               |                             |              |
|---------------|-----------------------------|--------------|
| METKA DWG.No. | —                           | DIN A0       |
| KKS DWG.No.   | <b>413-5-MAL-MDD-EA-300</b> | SCALE —      |
| EA DWG.No.    | 413-5-DT-M-11300            | SHEET 1 OF 2 |

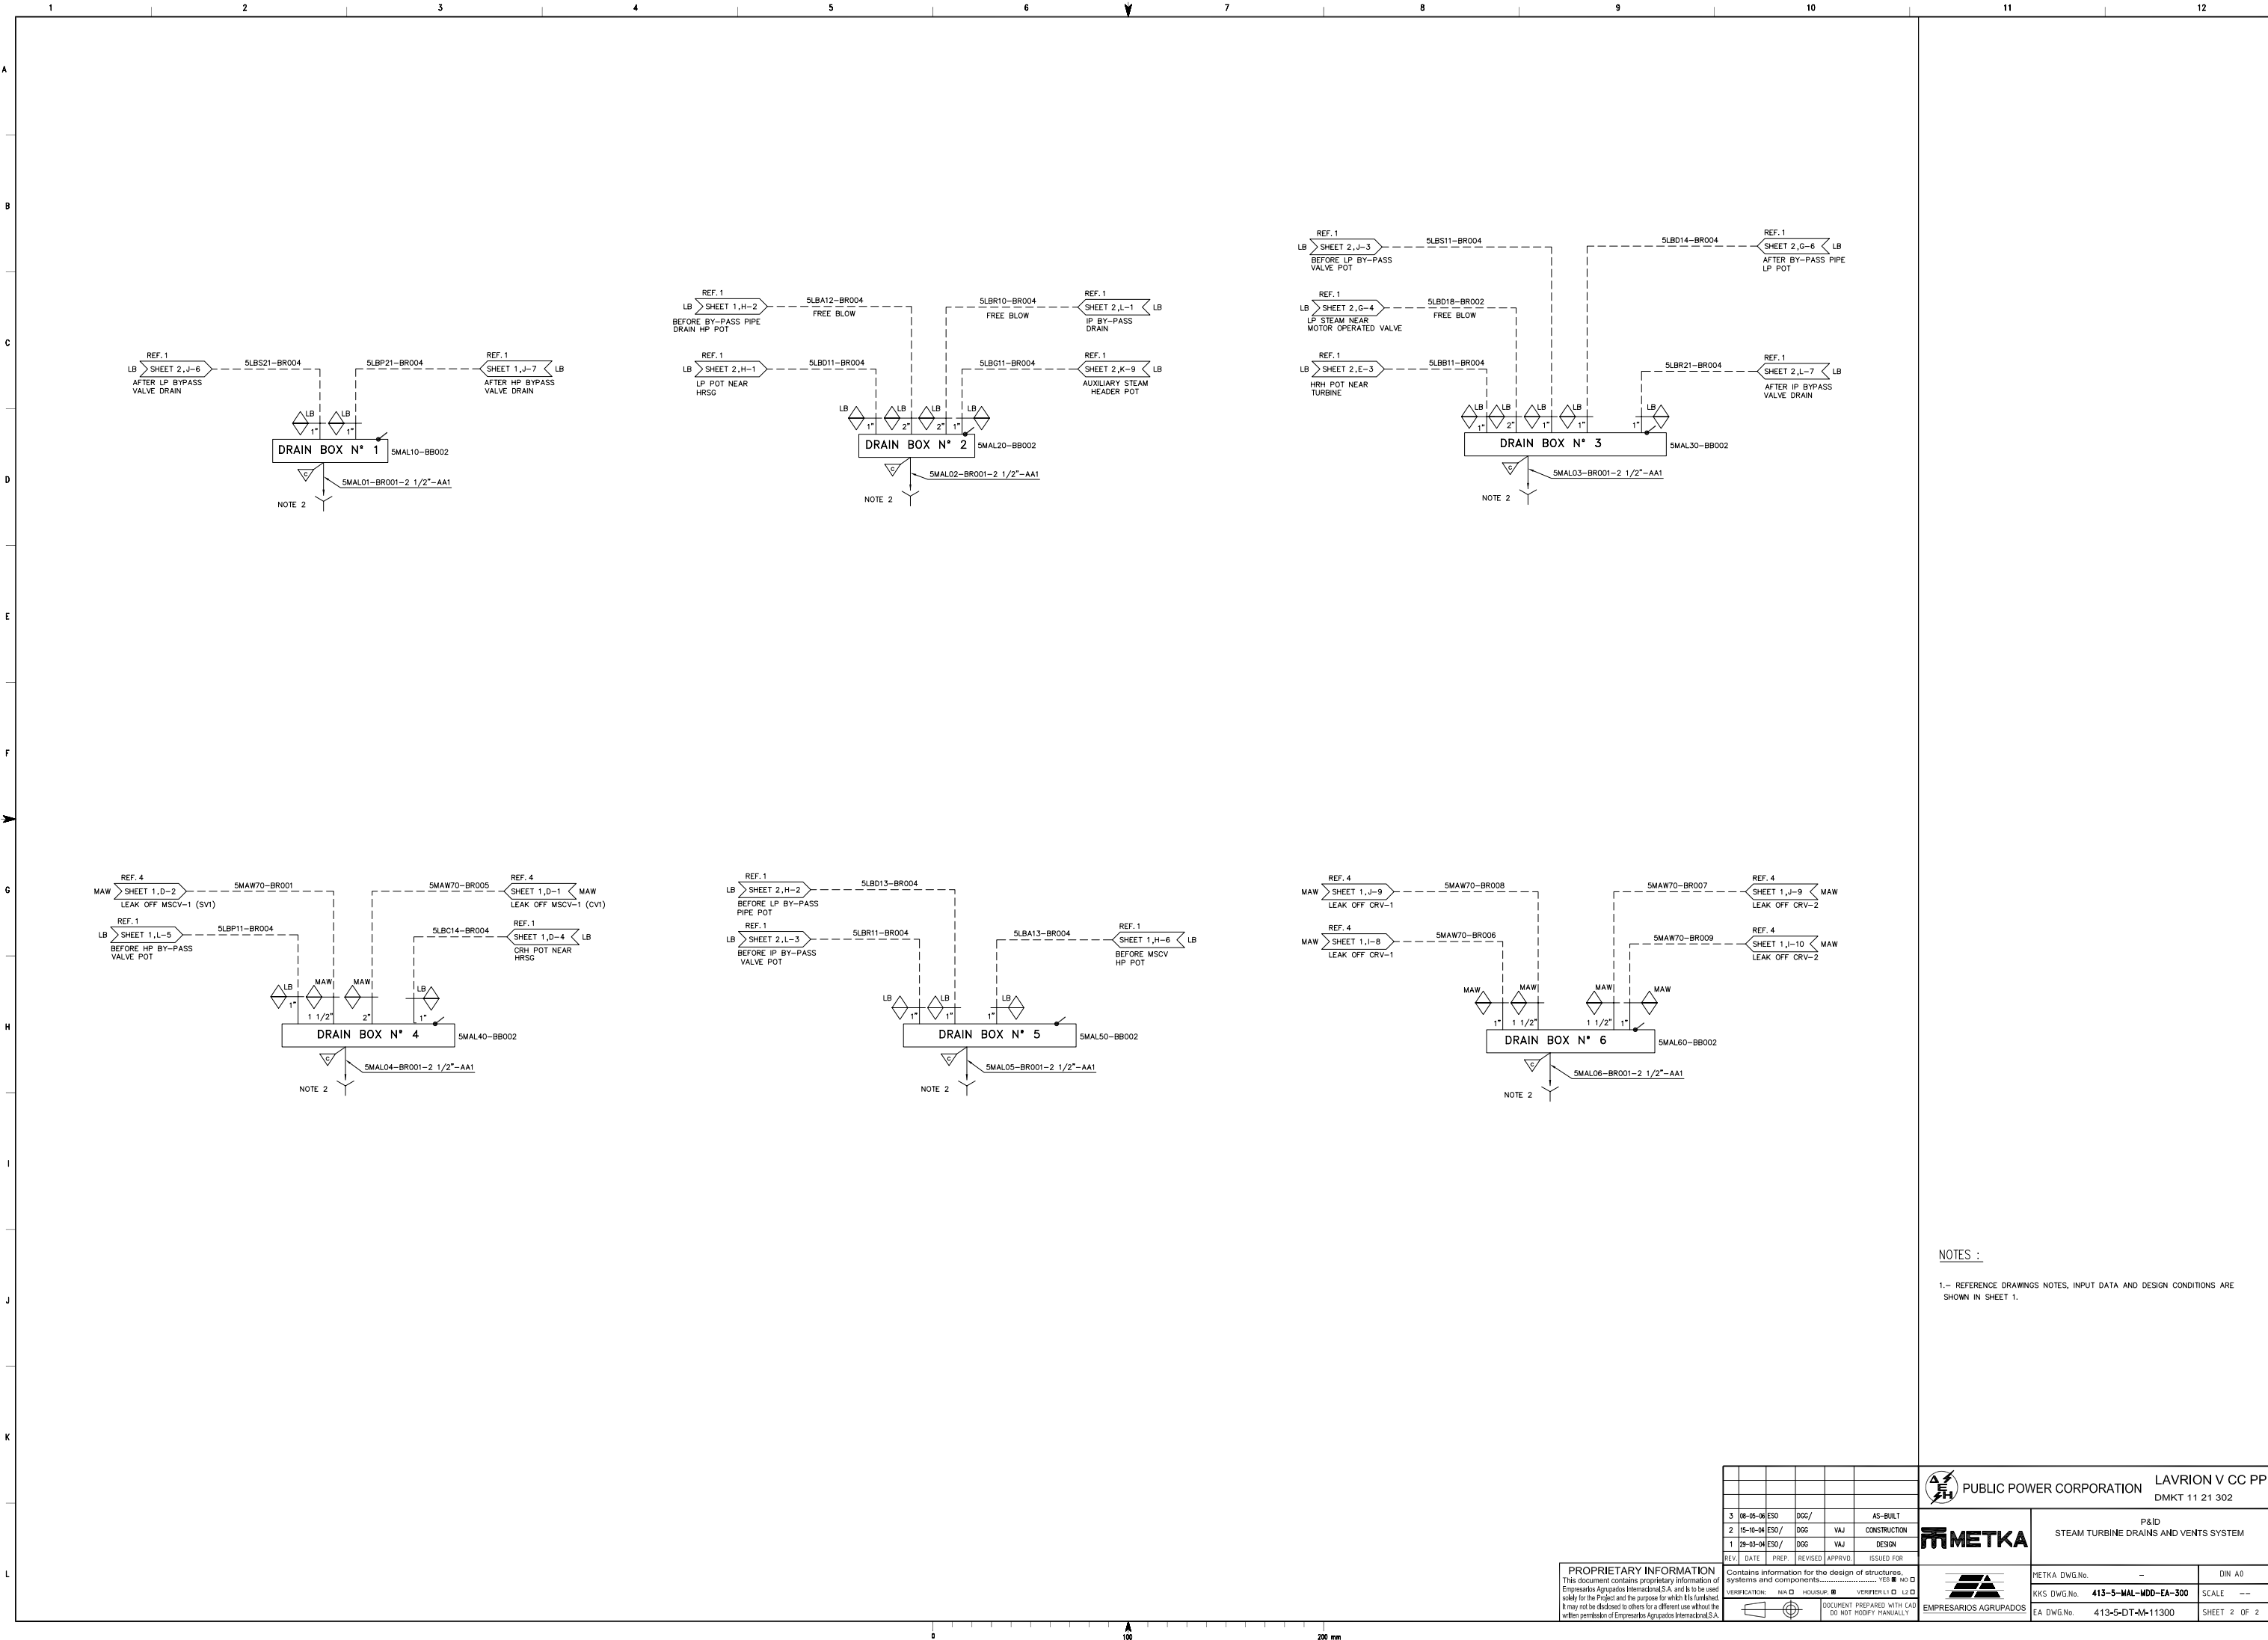

NOTES :

1.- REFERENCE DRAWINGS NOTES, INPUT DATA AND DESIGN CONDITIONS ARE SHOWN IN SHEET 1.

|  |  |  |  |                          |  |                                       |  |
|--|--|--|--|--------------------------|--|---------------------------------------|--|
|  |  |  |  | PUBLIC POWER CORPORATION |  | LAVRION V CC PP                       |  |
|  |  |  |  | DMKT 11 21 302           |  |                                       |  |
|  |  |  |  | METKA                    |  | P&ID                                  |  |
|  |  |  |  |                          |  | STEAM TURBINE DRAINS AND VENTS SYSTEM |  |
|  |  |  |  | METKA DWG.No.            |  | DIN A0                                |  |
|  |  |  |  | KKS DWG.No.              |  | SCALE                                 |  |
|  |  |  |  | EA DWG.No.               |  | SHEET 2 OF 2                          |  |

PROPRIETARY INFORMATION  
This document contains proprietary information of Empresarios Agrupados Internacional S.A. and is to be used solely for the Project and the purpose for which it is furnished. It may not be disclosed to others for a different use without the written permission of Empresarios Agrupados Internacional S.A.

|      |          |       |         |         |              |
|------|----------|-------|---------|---------|--------------|
| REV. | DATE     | PREP. | REVISED | APPROV. | ISSUED FOR   |
| 3    | 08-05-06 | ESD   | OGG     |         | AS-BUILT     |
| 2    | 15-10-04 | ESD   | OGG     | VAJ     | CONSTRUCTION |
| 1    | 29-03-04 | ESD   | OGG     | VAJ     | DESIGN       |

|                                                   |     |        |          |    |    |
|---------------------------------------------------|-----|--------|----------|----|----|
| VERIFICATION                                      | N/A | HOUSUP | VERIFIER | L1 | L2 |
| DOCUMENT PREPARED WITH CAD DO NOT MODIFY MANUALLY |     |        |          |    |    |



SCOPE OF SUPPLY BY ALSTOM  
(SEE REFERENCE N°3)

REFERENCE DRAWINGS CODE DRAWING N°

1.- P&ID SERVICE AND POTABLE WATER DISTRIBUTION SYSTEM GHB 413-5-DT-M-14100  
2.- P&ID PLANT & PROCESS DRAINS SYSTEM GMB 413-5-DT-M-14500  
3.- P&ID HRS&G-DRAINS AND VENTS SYSTEM HAN 11680BTD03305  
4.- P&ID COOLING WATER SYSTEM PG 413-5-DT-M-12200

NOTES :

- 1.- ALL LINES SHALL HAVE AN ISOLATION TO PROTECT THE PERSONNEL, WHICH COULD BE ELIMINATED IN AREAS WITHOUT RISK.  
2.- ALL HIGH POINTS SHALL CARRY A VENT, AND ALL LOW POINTS A DRAIN.  
3.- BLIND FLANGE FOR DRAIN CLEANING.  
4.- SCOPE OF SUPPLY LIMITS:  (ALSTOM POWER ITALIA S.p.A.)

INPUT DATA

- 1.- P&ID MECHANICAL DRAWINGS SYMBOLY AND GENERAL NOTES 413-5-DT-M-00300  
2.- MECHANICAL PROJECT CRITERIA, 413-5-R-M-00400  
3.- PIPING DATA SHEET 413-5-R-M-00403  
4.- SPECIFICATION FOR THERMAL INSULATION 413-5-I-M-24900  
5.- HRS&G DRAINS AND VENTS SYSTEM CALCULATIONS REPORT 413-5-F-M-11100

PRELIMINARY AND PENDING INFORMATION:

| DESIGN |     |     |
|--------|-----|-----|
| Branch | P   | T   |
|        | bar | °C  |
| a      | 4   | 150 |
| b      | 4   | 60  |
| c      | 8   | 60  |



PUBLIC POWER CORPORATION

LAVRION V CC PP  
DMKT 11 21 302

**METKA**




P&ID  
HRS&G DRAINS AND  
VENTS SYSTEM

METKA DWG.No. - DIN A0  
KKS DWG.No. 413-5-HAN-MDO-EA-100 SCALE --  
EA DWG.No. 413-5-DT-M-11100 SHEET 1 OF 1


PROPRIETARY INFORMATION  
This document contains proprietary information of  
Empresarios Agrupados Internacional S.A. and is to be used  
solely for the Project and the purpose for which it is furnished.  
It may not be disclosed to others for a different use without the  
written permission of Empresarios Agrupados Internacional S.A.

| REV.                                              | DATE     | PREP. | REVISED | APPROV. | ISSUED FOR   |
|---------------------------------------------------|----------|-------|---------|---------|--------------|
| 3                                                 | 08-05-06 | ESD   | OGG     |         | AS-BUILT     |
| 2                                                 | 01-05-04 | ESD   | OGG     | VAJ     | CONSTRUCTION |
| 1                                                 | 22-04-99 | ESD   | OGG     | VAJ     | DESIGN       |
| VERIFICATION: N/A G HOURS: 0 VERIFIER: L1 G L2 G  |          |       |         |         |              |
| DOCUMENT PREPARED WITH CAD DO NOT MODIFY MANUALLY |          |       |         |         |              |



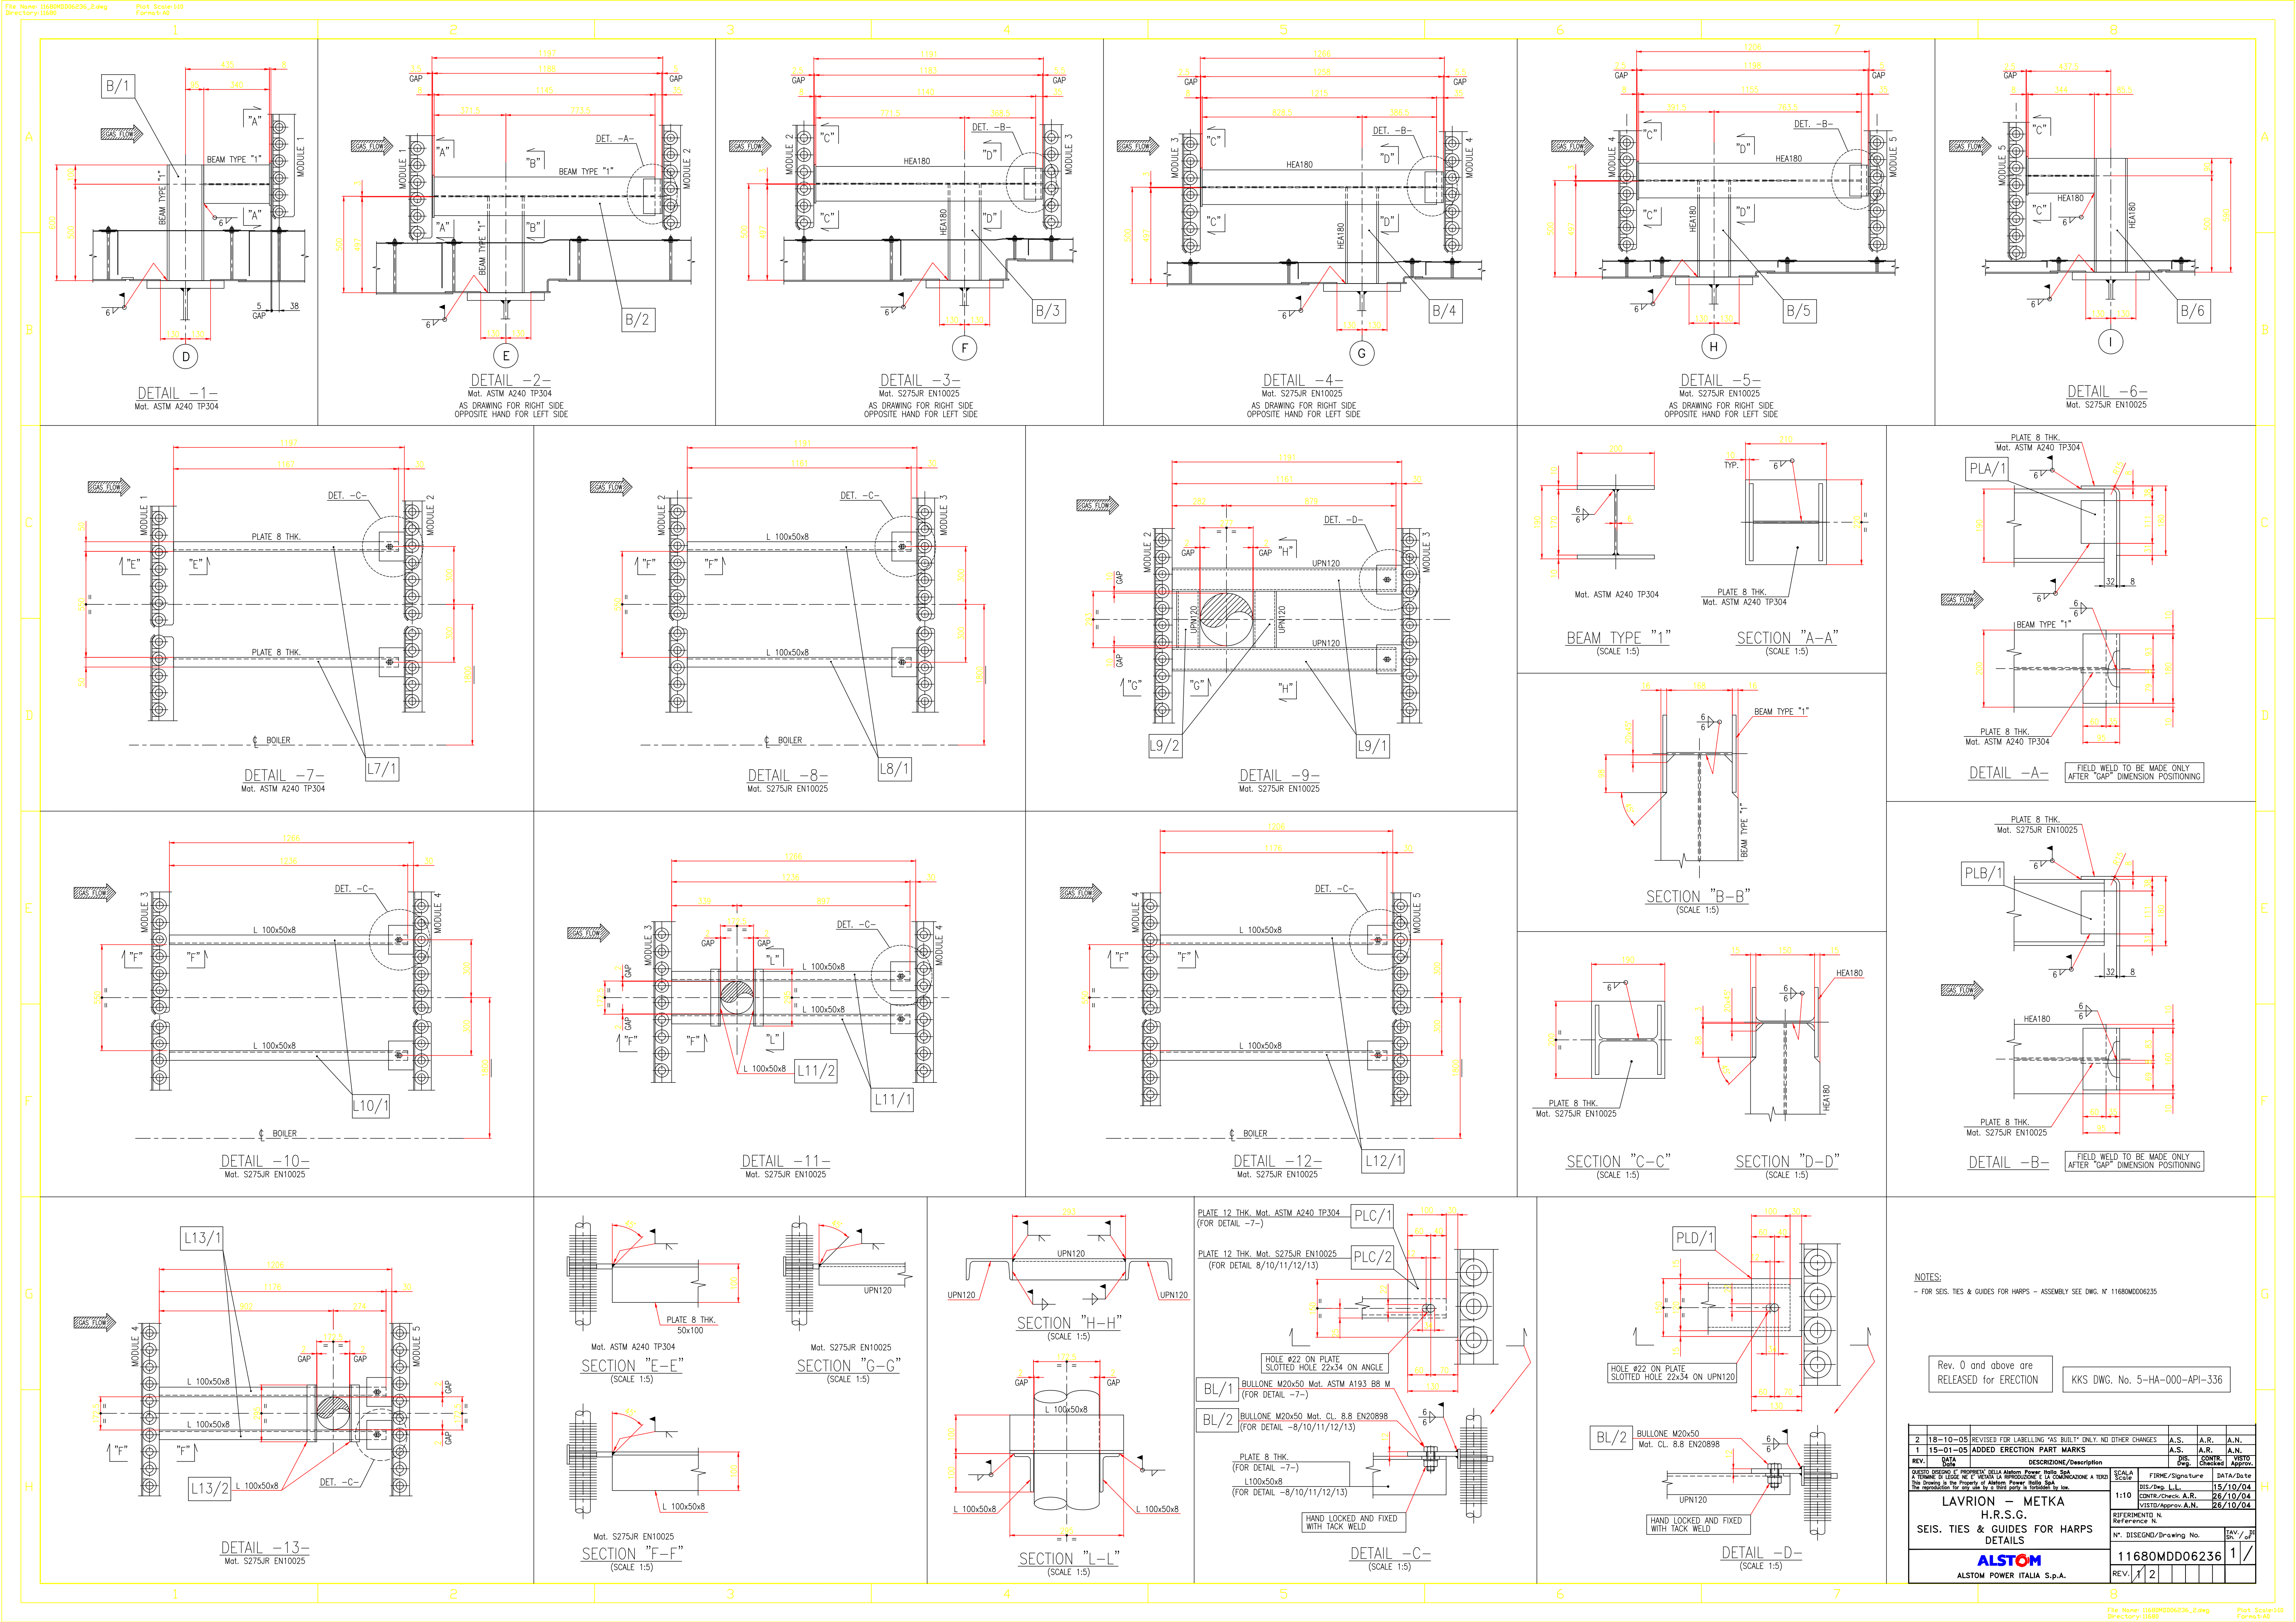



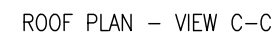

- ASSEMBLY PLANS AND SECTION SEE DWG. N°11680MDD01700
- SECTION E-E AND SECTION ROW "E" - "G" - "J" SEE DWG. N°11680MDD01701
- ROOF PURLINS PLAN SEE DWG. N°11680MDD01702
- DETAILS FROM "1" TO "9" SEE DWG. N°11680MDD01703
- DETAILS FROM "10" TO "12" SEE DWG. N°11680MDD01704
- DETAILS FROM "13" TO "18" SEE DWG. N°11680MDD01705
- FOR MATERIAL FASCET CANOPY STRUCTURE SEE DOC. N°11680MDF01700

KKS DWG. No. 5-HA-000-API-318

[illegible]



MARKING INSTRUCTIONS FOR SHOP DRAWINGS AND ERECTION:

- ELDINGS:

- 
- Diagram of a beam of length  $l$  with a triangular load. The load intensity is  $q$  at the left end and  $0$  at the right end. The reaction force at the right end is  $R$ . The load is represented by a triangle with a peak of  $q$  and a base of  $l$ . The reaction force  $R$  is shown as an upward arrow at the right end. The load is labeled  $q$  and the reaction force is labeled  $R$ . The beam length is  $l$ . The load is represented by a triangle with a peak of  $q$  and a base of  $l$ . The reaction force  $R$  is shown as an upward arrow at the right end. The load is labeled  $q$  and the reaction force is labeled  $R$ . The beam length is  $l$ .

**MATERIALS:**

- |                     |                                                     |
|---------------------|-----------------------------------------------------|
| BEAMS & PLATES      | S275JR EN 10025                                     |
| BOLTS               | Cl. 8.8 – EN20898 – UNI 5737 / DIN 931 (GALVANIZED) |
| NUTS                | Cl. 8 – EN20898 – UNI 5588 / DIN 934                |
| WASHER (N.1 x BOLT) | R80 – EN20898 – UNI 6592 / DIN 125/A                |

NOTES:

- ALL DIMENSIONS ARE MILLIMETERS UNLESS DIFFERENTLY SHOWN.  
ALL ELEVATIONS REFER TO QUOTE +0,00 FINISHED GROUND FLOOR.  
ARRANGEMENT SHOWN IS FOR (1) ONE UNIT, (1) ONE UNIT  
ON THIS CONTRACT.  
FOR ALL OTHER MANUFACTURING, TESTING AND PAINTING INSTRUCTIONS  
REFER TO M.R. 11680MDR06200.

RECTION/LIFTING PROCEDURE:

- THE FABRICATOR/ERECTOR IS RESPONSABLE FOR DESIGN & SUPPLY OF ANY EXTRA LIFTING ATTACHMENTS REQUIRED, INCLUDING TRUNNIONS, BRACING AND LUGS ETC. DETAILS OF LIFTING ATTACHMENTS TO BE SUBMITTED TO A.P.I. FOR APPROVAL. NOTE THAT ANY INTERNAL TRUNNIONS OR BRACING MUST BE REMOVED AFTER ERECTION.


REFERENCE DRAWINGS:

- FOR CANOPY STRUCTURE ASSEMBLY PLANS & SECTIONS SEE DWG. N. 11680MDD01700  
FOR SILENCERS SUPPORT STRUCTURE DETAILS SK-01 ÷ SK-05 SEE DWG. N. 11680MDD01721  
FOR SILENCERS SUPPORT STRUCTURE DETAILS SK-06 ÷ SK-10 SEE DWG. N. 11680MDD01722  
FOR SILENCER DRAWINGS SEE DWG. N. 11680MAD23200 From Sh.1 To Sh.13  
FOR SILENCERS SUPPORT STRUCTURE MATERIAL FORECAST SEE DOC. N. 11680MDF01720


KKS DWG. No. 5-HA-000-API-331

|                                                                                                                                                                                                       |  |                |                    |           |
|-------------------------------------------------------------------------------------------------------------------------------------------------------------------------------------------------------|--|----------------|--------------------|-----------|
| DESCRIZIONE/Description                                                                                                                                                                               |  | Dwg.           | Checked            | Approv.   |
| "E' PROPRIETA' DELLA Alstom Power Italia SpA<br>E NE E' VIETATA LA RIPRODUZIONE E LA COMUNICAZIONE A TERZI<br>Property of Alstom Power Italia SpA<br>or any use by a third party is forbidden by law. |  | SCALA<br>Scale | FIRME/Signature    | DATA/Date |
| AVVRION - METKA                                                                                                                                                                                       |  | 1:75           | DIS./Dwg. I.L.     | 03/12/04  |
|                                                                                                                                                                                                       |  |                | CONTR./Check.A.R.  | 10/12/04  |
|                                                                                                                                                                                                       |  |                | VISTI/Approved. N. | 10/12/04  |




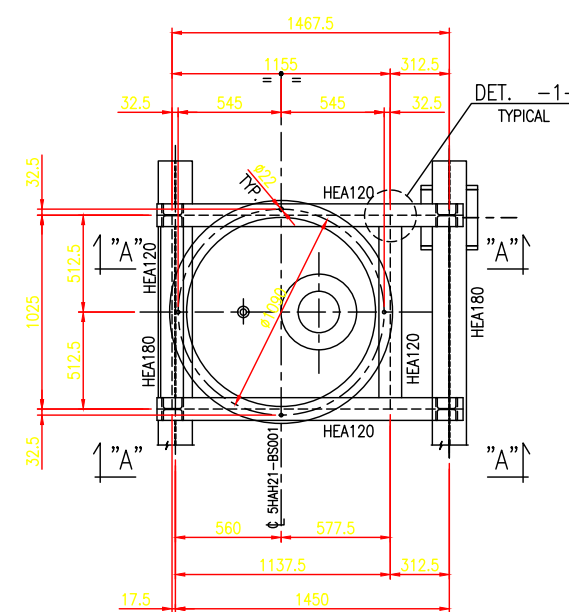


SKID SK-01  
SILENCER 5HAH21-BS001

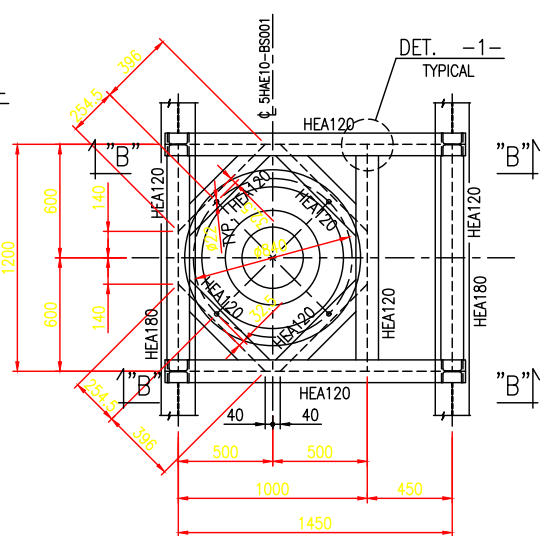


SKID SK-02  
SILENCER 5HAE10-BS001

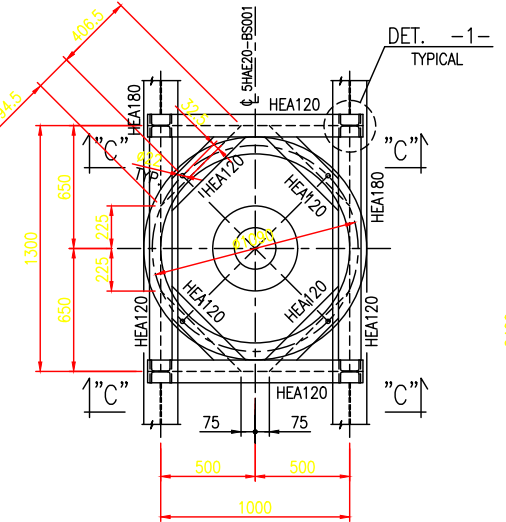


SKID SK-03  
SILENCER 5HAE20-BS001

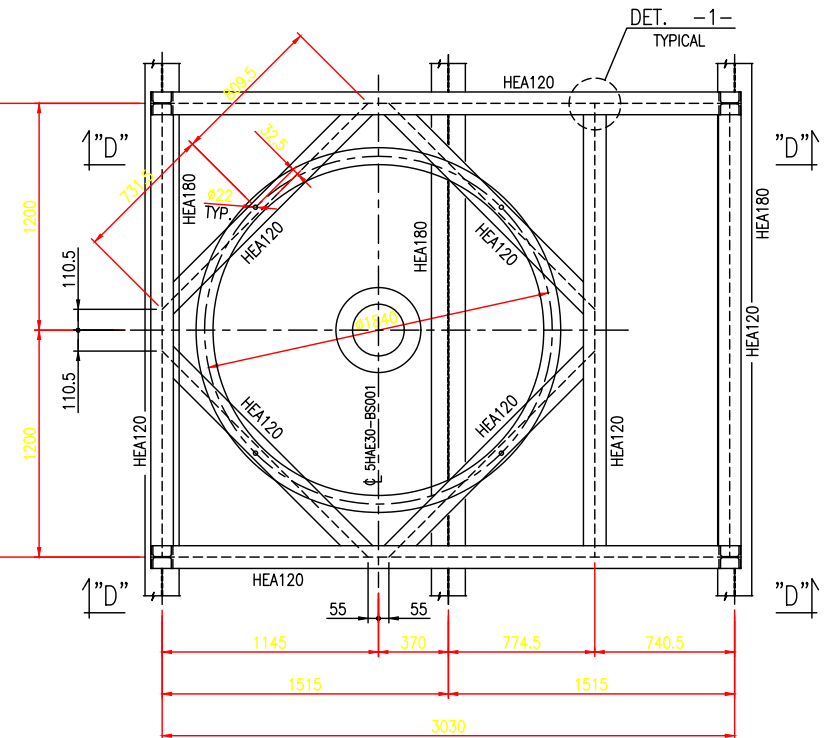


SKID SK-04  
ILENCER 5HAE30-BS001

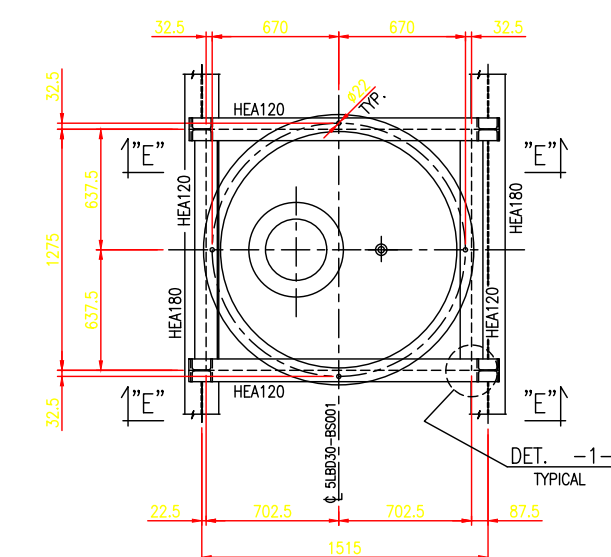


SKID SK-05  
SILENCER 5LBD30-BS001

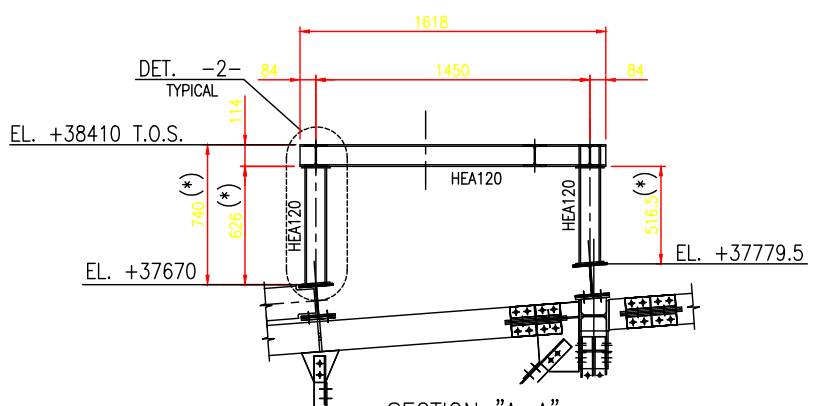


SECTION "A-A"  
(\* ) TO BE CHECKED ON SITE

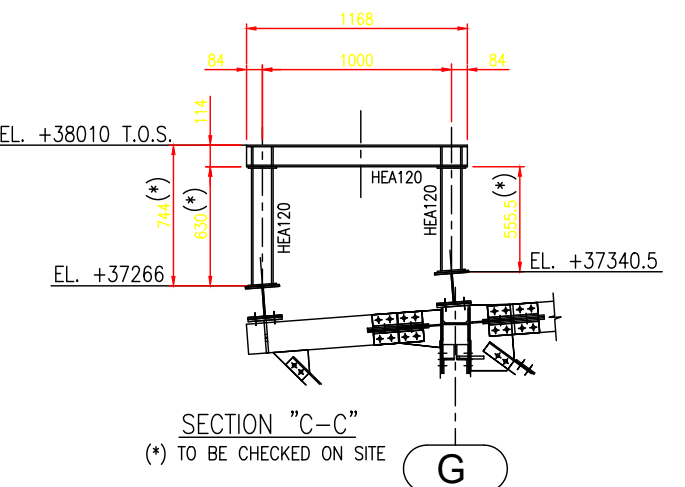


SECTION "C-C"  
(\*) TO BE CHECKED ON SITE

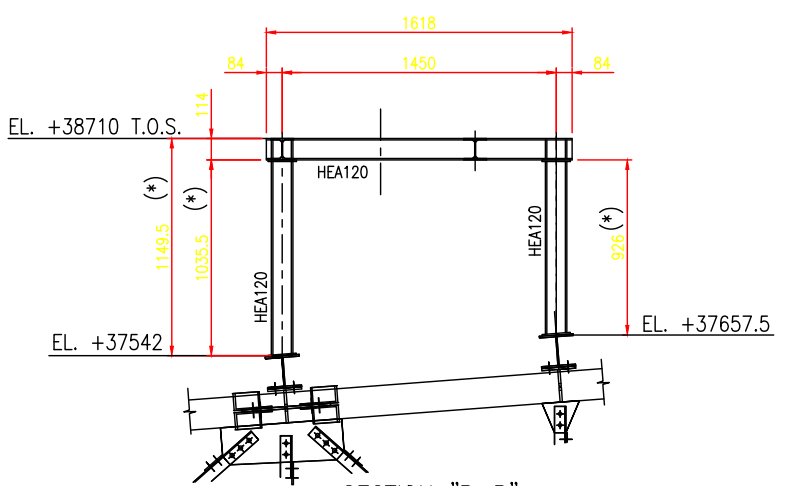

SECTION "B-B"  
(\*) TO BE CHECKED ON SITE

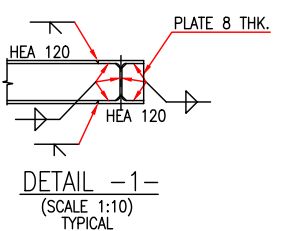


DETAIL -1-  
(SCALE 1:10)  
TYPICAL

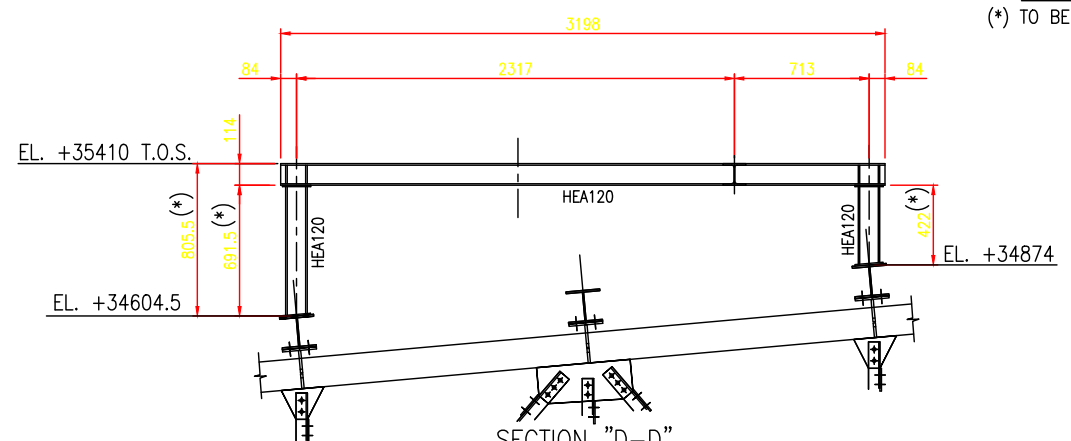


SECTION "D-D"

(\*) TO BE CHECKED ON SITE

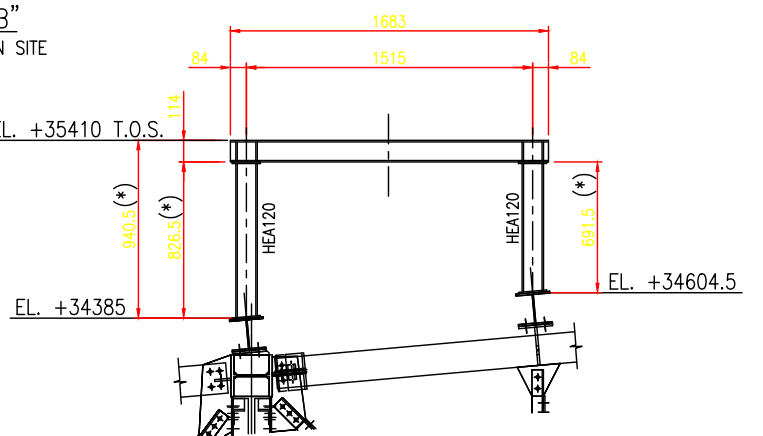

SECTION "E-E"  
\*) TO BE CHECKED ON SITE

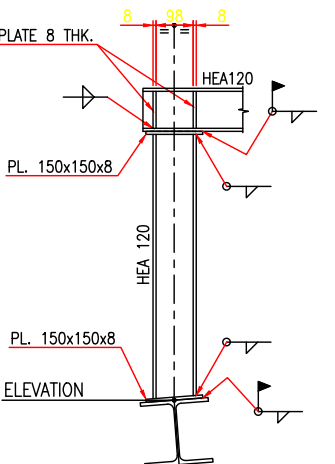

DETAIL -2-  
(SCALE 1:10)  
TYPICAL

REFERENCE DRAWINGS:

- FOR SILENCER SUPPORTS ASSEMBLY & NOTES SEE DWG. N. 11680MDD01720  
FOR SILENCER SUPPORTS SK-06/07/08/09/10 SEE DWG. N. 11680MDD01722  
FOR SILENCER DRAWINGS SEE DWG. N. 11680MAD23200 From Sh.1 To Sh.13

Rev. 0 and above are  
RELEASED for ERECTION

PKS DWG. No. 5-HA-000-API-332

|                                                                                                                                                                                                                                                                                                                 |              |                                                                                                               |                                |                                                         |                                  |
|-----------------------------------------------------------------------------------------------------------------------------------------------------------------------------------------------------------------------------------------------------------------------------------------------------------------|--------------|---------------------------------------------------------------------------------------------------------------|--------------------------------|---------------------------------------------------------|----------------------------------|
| 2                                                                                                                                                                                                                                                                                                               | 18-10-05     | REVISED FOR LABELLING 'AS BUILT' ONLY. NO OTHER CHANGES                                                       | A.S.                           | A.R.                                                    | A.N.                             |
| 1                                                                                                                                                                                                                                                                                                               | 14-03-05     | REVISED WHERE INDICATED  | M.B.                           | A.R.                                                    | A.N.                             |
| REV.                                                                                                                                                                                                                                                                                                            | DATA<br>Disa | DESCRIZIONE/Description                                                                                       | DIS.<br>Dwg.                   | CONTR.<br>Checked                                       | VISTO<br>Approv.                 |
| <p>QUESTO DISEGNO E' PROPRIETA' DELLA Alstom Power Italia SpA<br/>         A TERMINE DI LEONE NE E' VIETATA LA RIPRODUZIONE E LA COMUNICAZIONE A TERZI<br/>         This Drawing is the Property of Alstom Power Italia SpA<br/>         The reproduction for any use by a third party is forbidden by law.</p> |              |                                                                                                               | SCALA<br>Scale                 | FIRME/Signature                                         | DATA/Date                        |
|                                                                                                                                                                                                                                                                                                                 |              |                                                                                                               | 1:20                           | DIS./Dwg.L.L.<br>CONTR./Check.A.R.<br>VISTO/Approv.A.N. | 10/01/05<br>20/01/05<br>20/01/05 |
| LAVRION - METKA<br>CANOPY<br>SILENCER STRUCTURE<br>DETAIL SKID SK-01/02/03/04/05                                                                                                                                                                                                                                |              |                                                                                                               | RIFERIMENTO N.<br>Reference N. |                                                         | TAV.<br>Sh. / of                 |
|                                                                                                                                                                                                                                                                                                                 |              |                                                                                                               | N°. DISEGNO/Drawing No.        |                                                         |                                  |
|                                                                                                                                                                                                                                                                                                                 |              |                                                                                                               | 11680MDD01721                  |                                                         | 1 /                              |
| REV.                                                                                                                                                                                                                                                                                                            |              |                                                                                                               | 1                              | 2                                                       |                                  |
| <br>ALSTOM POWER ITALIA S.p.A.                                                                                                                                                                                             |              |                                                                                                               |                                |                                                         |                                  |

